

USE TYPEWRITER OR BALL POINT PEN-PRESS FIRMLY, PRINT CLEARLY.




T R EW sec 1/4 1/4 1/4 No.

WATER WELL RECORD  
KSA 82a-1201-1215

Kansas State Dept. Of Health  
(Water Well Contractors)  
Forbes-Bldg. 740  
Topeka, Kansas 66620

Location of well: POTAWATOMIE County: POTAWATOMIE Township name: BICE Fraction: NE 1/4 - NE 1/4 SE 1/4 Section number: 5 10 Town number: 10 Range number: 8 E

Distance and direction from nearest town or city: 3 E - 1/4 S of Manhattan  
Street address of well location if in city: \_\_\_\_\_  
3 Owner of well: Ray Stephenson  
Address: RFD 1 AT. Geo. Kansas

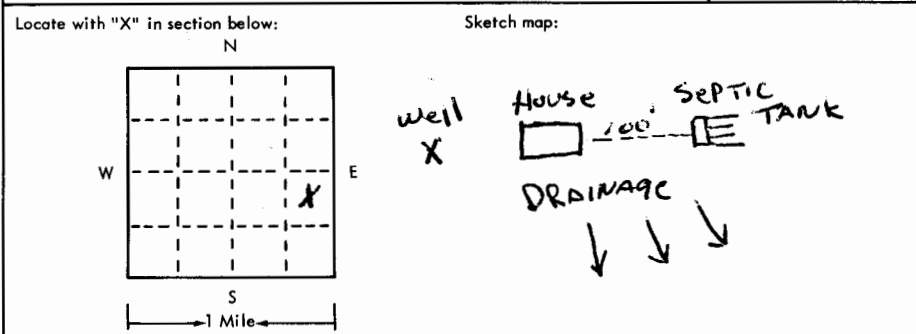

4 Well depth: 50 ft. Date of completion 7-7-75  
Well diameter 10 in.

5  Cable tool  Rotary  Driven  Dug  
 Hollow rod  Jetted  Bored  Reverse rotary

6 Use:  Domestic  Public supply  Industry  
 Irrigation  Air conditioning  Commercial  
 Test well  \_\_\_\_\_

7 Casing: Material PVC Height: above/below  
Threaded  Welded  Surface 24 in.  
Diam. \_\_\_\_\_ Weight 2.33 lbs./ft.  
0 in. to 50 ft. depth Drive shoe?  Yes  No  
\_\_\_\_ in. to \_\_\_\_ ft. depth

2	Type and color of material	From	To
	<u>Top Soil</u>	<u>0</u>	<u>5</u>
	<u>Brown Clay</u>	<u>5</u>	<u>38</u>
	<u>Coarse Sand</u>	<u>38</u>	<u>42</u>
	<u>COARSE SAND - Pea GRAVEL</u>	<u>42</u>	<u>50</u>

8 Screen:  
Manufacturer Pump Co  
Type PVC Dia. 5  
Slot/\_\_\_\_\_ Length 5  
Set between 45 ft. and 50 ft.  
Fittings:  
Gravel pack  Yes  No Size range of material 1/8

9 Static water level: NOT MEASURED  
34 ft. below land surface Date 7-9-75

10 Pumping level below land surfaces: Air TEST  
\_\_\_\_ ft. after \_\_\_\_ hrs. pumping \_\_\_\_ g.p.m.  
\_\_\_\_ ft. after \_\_\_\_ hrs. pumping \_\_\_\_ g.p.m.  
Estimated maximum yield 30 g.p.m.

11 Water sample submitted:  
 Yes  No Date \_\_\_\_\_

12 Well head completion: CAPPED  
 Pitless adapter 24  Inches above grade

13 Well grouted?  Yes  No  
 Neat cement  Bentonite  \_\_\_\_\_  
Depth: From 0 ft. to 10 ft.

14 Nearest source of possible contamination:  
ft. 150 Direction N. W. Type S. Tank  
Well disinfected upon completion?  Yes  No

15 Pump:  Not installed  
Manufacturer's name \_\_\_\_\_  
Model number \_\_\_\_\_ HP \_\_\_\_\_ Volts \_\_\_\_\_  
Length of drop pipe \_\_\_\_\_ ft. capacity \_\_\_\_\_ g.m.p.  
Type:  
 Submersible  Turbine  
 Jet  Reciprocating  
 Centrifugal  Other

16 Remarks: elevation 1010  
Topography:  Hill  Slope  Upland  Valley  
Owners to Install Slab

17 Water well contractor's certification:  
This well was drilled under my jurisdiction and this report is true to the best of my knowledge and belief.  
Strader Drilling Co Inc 182  
Business name License No. \_\_\_\_\_  
Address RFD 1 Holton, Kansas  
Signed Paul Ashwin Date 7-21-75  
Authorized representative

10 SE 5 C NE SE

USE TYPEWRITER OR BALL POINT PEN-PRESS FIRMLY, PRINT CLEARLY.

WATER WELL RECORD  
KSA 82a-1201-1215

T R EW sec 1/4 1/4 1/4 No.

Kansas State Dept. Of Health  
(Water Well Contractors)  
Forbes-Bldg. 740  
Topeka, Kansas 66620

1 Location of well:	County: <u>ROT. Aux. Topeka</u>	Township name: <u>Blue</u>	Fraction: <u>NE 1/4 - NE 1/4 - SE 1/4</u>	Section number: <u>810</u>	Town number: <u>10</u>	Range number: <u>8</u>
Distance and direction from nearest town or city:				3 Owner of well: <u>RAY Stephenson</u>		
Street address of well location if in city:				Address: <u>RR 1 S.T. Geo. Kansas</u>		
Locate with "X" in section below:				Sketch map:		
2 Type and color of material		From	To	4 Well depth: <u>50</u> ft. Date of completion <u>7-8-75</u> Well diameter <u>10</u> in.		
<u>Top Soil</u>		<u>0</u>	<u>6</u>	5 <input type="checkbox"/> Cable tool <input checked="" type="checkbox"/> Rotary <input type="checkbox"/> Driven <input type="checkbox"/> Dug <input type="checkbox"/> Hollow rod <input type="checkbox"/> Jetted <input type="checkbox"/> Bored <input type="checkbox"/> Reverse rotary		
<u>Brown Clay</u>		<u>6</u>	<u>38</u>	6 Use: <input checked="" type="checkbox"/> Domestic <input type="checkbox"/> Public supply <input type="checkbox"/> Industry <input type="checkbox"/> Irrigation <input type="checkbox"/> Air conditioning <input type="checkbox"/> Commercial <input type="checkbox"/> Test well		
<u>Fine sand - COARSE SAND</u>		<u>38</u>	<u>41</u>	7 Casing: Material <u>PVC</u> Height: above/below Threaded <input type="checkbox"/> Welded <input type="checkbox"/> Surface <u>24</u> in. Diam. _____ Weight <u>233</u> lbs./ft. <u>5</u> in. to <u>50</u> ft. depth Drive shoe? <input type="checkbox"/> Yes <input checked="" type="checkbox"/> No _____ in. to _____ ft. depth		
<u>COARSE SAND - PEA GRAVEL</u>		<u>41</u>	<u>50</u>	8 Screen: Manufacturer <u>Pump Co</u> Type <u>PVC</u> Dia. <u>5"</u> Slot/gauge <u>.025</u> Length <u>7'</u> Set between <u>43</u> ft. and <u>50</u> ft. Fittings: _____ # <u>20</u> Gravel pack <input checked="" type="checkbox"/> Yes <input type="checkbox"/> No Size range of material _____		
				9 Static water level: <u>NOT MEASURED</u> <u>28</u> ft. below land surface Date <u>7-8-75</u>		
				10 Pumping level below land surfaces: <u>AIR TEST</u> _____ ft. after _____ hrs. pumping _____ g.p.m. _____ ft. after _____ hrs. pumping _____ g.p.m. Estimated maximum yield <u>3.0</u> g.p.m.		
				11 Water sample submitted: <input type="checkbox"/> Yes <input checked="" type="checkbox"/> No Date _____		
				12 Well head completion: <u>Capped</u> <input type="checkbox"/> Pitless adapter <u>24</u> <input checked="" type="checkbox"/> Inches above grade		
				13 Well grouted? <input checked="" type="checkbox"/> Yes <input type="checkbox"/> No <input checked="" type="checkbox"/> Neat cement <input type="checkbox"/> Bentonite <input type="checkbox"/> _____ Depth: From <u>0</u> ft. to <u>10</u> ft.		
				14 Nearest source of possible contamination: ft. <u>100</u> Direction <u>N.E</u> Type <u>S.Tank</u> Well disinfected upon completion? <input checked="" type="checkbox"/> Yes <input type="checkbox"/> No		
				15 Pump: <input checked="" type="checkbox"/> Not installed Manufacturer's name _____ Model number _____ HP _____ Volts _____ Length of drop pipe _____ ft. capacity _____ g.m.p. Type: <input type="checkbox"/> Submersible <input type="checkbox"/> Turbine <input type="checkbox"/> Jet <input type="checkbox"/> Reciprocating <input type="checkbox"/> Centrifugal <input type="checkbox"/> Other		
16 Remarks: elevation <u>1010</u> <u>Owner To Install slab</u>				17 Water well contractor's certification: This well was drilled under my jurisdiction and this report is true to the best of my knowledge and belief. <u>STRADER DRILLING CO INC 182</u> Business name License No. _____ Address <u>P.O. 1 Holton KS 66436</u> Signed <u>Dale Baker</u> Date <u>7-13-75</u> Authorized representative		
Topography: <input type="checkbox"/> Hill <input type="checkbox"/> Slope <input type="checkbox"/> Upland <input checked="" type="checkbox"/> Valley						

10 SE 8E 3- C NE SE