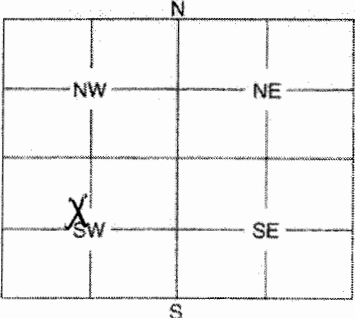


1 LOCATION OF WATER WELL: Riley County:	Fraction SE 1/4 NW 1/4 SW 1/4	Section Number 18	Township Number 10	Range Number 8
--	---	-----------------------------	------------------------------	--------------------------

Distance and direction from nearest town or city street address of well if located within city?
1531 Poyntz Avenue, Manhattan, Ks

2 WATER WELL OWNER: Calvin Emmick c/o KDHE T&M RR #, St. Address, Box #: 1000 SW Jackson #410 City, State, ZIP Code : Topeka, Ks 66612-1367	Board of Agriculture, Division of Water Resources Application Number:
--	--

3 MARK WELL'S LOCATION WITH AN "X" IN SECTION BOX: 	4 DEPTH OF WELL 33.80 ft. WELL'S STATIC WATER LEVEL .23.07 ... ft. WELL WAS USED AS: <table style="width:100%; border: none;"> <tr> <td>1 Domestic</td> <td>5 Public Water Supply</td> <td>9 Dewatering</td> </tr> <tr> <td>2 Irrigation</td> <td>6 Oil Field Water Supply</td> <td>10 Monitoring Well</td> </tr> <tr> <td>3 Feedlot</td> <td>7 Domestic (Lawn & Garden)</td> <td>11 Injection Well</td> </tr> <tr> <td>4 Industrial</td> <td>8 Air Conditioning</td> <td>12 Other</td> </tr> </table> <p>Was a chemical / bacteriological sample submitted to Department? Yes No X..... If yes, mo/day/yr sample was submitted</p> <p>Water Well Disinfected: Yes No X.....</p>	1 Domestic	5 Public Water Supply	9 Dewatering	2 Irrigation	6 Oil Field Water Supply	10 Monitoring Well	3 Feedlot	7 Domestic (Lawn & Garden)	11 Injection Well	4 Industrial	8 Air Conditioning	12 Other
1 Domestic	5 Public Water Supply	9 Dewatering											
2 Irrigation	6 Oil Field Water Supply	10 Monitoring Well											
3 Feedlot	7 Domestic (Lawn & Garden)	11 Injection Well											
4 Industrial	8 Air Conditioning	12 Other											

5 TYPE OF BLANK CASING USED:

1 Steel	3 RMP (SR)	5 Wrought	7 Fiberglass	9 Other (Specify below)
2 PVC	4 ABS	6 Asbestos-Cement	8 Concrete Tile	

Blank casing diameter **2** in. Was casing pulled? Yes **X** No If yes, how much **NA 20'**
Casing height above or below land surface in.

6 GROUT PLUG MATERIAL: **3** Neat cement **2** Cement grout **3** Bentonite **4** Other **Surface silts and clays**.....

Grout Plug Intervals: From **20** ft. to **3** ft., From **3** ft. to **0** ft., From to ft.

What is the nearest source of possible contamination:

1 Septic tank	6 Seepage pit	11 Fuel storage	16 Other (specify below)
2 Sewer lines	7 Pit privy	12 Fertilizer storage	
3 Watertight sewer lines	8 Sewage lagoon	13 Insecticide storage	
4 Lateral lines	9 Feedyard	14 Abandoned water well	
5 Cess pool	10 Livestock pens	15 Oil well/Gas well	

Direction from well? How many feet?

FROM	TO	PLUGGING MATERIALS
20	3	Bentonite
3	0	Surface silts/clays
		overdrilled to 20'

7 CONTRACTOR'S OF LANDOWNER'S CERTIFICATION: This water well was plugged under my jurisdiction and was completed on (mo/day/year) **07/06/06** and this record is true to the best of my knowledge and belief. Kansas Water Well Contractor's License No. **585**. This Water Well Record was completed on (mo/day/year) **08/01/06** under the business name of **Associated Environmental, Inc.** by (signature) **B. Johnson**

INSTRUCTIONS: Use typewriter or ball point pen. Please press firmly and print clearly. Please fill in blanks, underline or circle the correct answers. Send top three copies to Kansas Department of Health and Environment, Bureau of Water, Geology Section, 1000 SW Jackson St., Ste. 420, Topeka, Kansas 66612-1367. Telephone: 785/296-5522. Send one to Water Well Owner and retain one for your records.