


1 LOCATION OF WATER WELL: County: Pottawatomie	Fraction SE ¼ NE ¼ SW ¼	Section Number 9	Township Number T 10 S	Range Number R 8 E/W
--	-----------------------------------	----------------------------	----------------------------------	--------------------------------

Distance and direction from nearest town or city street address of well if located within city?
1111 Kretschmer Dr., Manhattan

2 WATER WELL OWNER: RR#, St. Address, Box # City, State, ZIP Code	Quaker Oats Food & Beverage Co. 1111 Kretschmer Drive Manhattan, KS 66502	Board of Agriculture, Division of Water Resources Application Number:
---	---	--

3 LOCATE WELL'S LOCATION WITH AN "X" IN SECTION BOX:

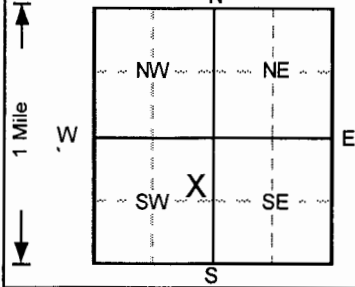

4 DEPTH OF COMPLETED WELL **35** ft. ELEVATION:

Depth(s) Groundwater Encountered 1. ft. 2. ft. 3. ft.

WELL'S STATIC WATER LEVEL **25.11** ft. below land surface measured on mo/day/yr **1/8/2007**

Pump test data: Well water was **NA** ft. after hours pumping gpm

Est. Yield **NA** gpm: Well water was ft. after hours pumping gpm

Bore Hole Diameter **8** in. to **35** ft., and in. to ft.

WELL WATER TO BE USED AS:

5 Public water supply	8 Air conditioning	11 Injection well
1 Domestic	3 Feedlot	6 Oil field water supply
2 Irrigation	4 Industrial	7 Lawn and garden only
		10 Monitoring well

12 Other (Specify below)

Was a chemical/bacteriological sample submitted to Department? Yes.....No ; If yes, mo/day/yr sample was submitted

Water Well Disinfected? Yes No

5 TYPE OF BLANK CASING USED:

1 Steel	3 RMP (SR)	5 Wrought iron	8 Concrete tile	CASING JOINTS: Glued	Clamped
2 PVC	4 ABS	6 Asbestos-Cement	9 Other (specify below)	Welded	
		7 Fiberglass		Threaded	<input checked="" type="checkbox"/>

Blank Casing diameter **2** in. to **25** ft., Dia. in. to ft., Dia. in. to ft.

Casing height above land surface **29.16** in., weight lbs./ft. Wall thickness or gauge No. **Sch. 40**

TYPE OF SCREEN OR PERFORATION MATERIAL

1 Steel	3 Stainless steel	5 Fiberglass	7 PVC	10 Asbestos-cement
2 Brass	4 Galvanized steel	6 Concrete tile	8 RMP (SR)	11 Other (specify)
			9 ABS	12 None used (open hole)

SCREEN OR PERFORATION OPENINGS ARE:

1 Continuous slot	3 Mill slot	5 Gauzed wrapped	8 Saw cut	11 None (open hole)
2 Louvered shutter	4 Key punched	6 Wire wrapped	9 Drilled holes	
		7 Torch cut	10 Other (specify)	

SCREEN-PERFORATED INTERVALS: From **25** ft. to **35** ft., From ft. to ft.

GRAVEL PACK INTERVALS: From **20.5** ft. to **35** ft., From ft. to ft.

6 GROUT MATERIAL: 1 Neat cement **2 Cement grout** **3 Bentonite** **4 Other Concrete**

Grout Intervals: From **0** ft. to **2** ft., From **2** ft. to **15.5** ft., From **15.5** ft. to **20.5** ft.

What is the nearest source of possible contamination:

1 Septic tank	4 Lateral lines	7 Pit privy	10 Livestock pens	14 Abandoned water well
2 Sewer lines	5 Cess pool	8 Sewage lagoon	11 Fuel storage	15 Oil well/Gas well
3 Watertight sewer lines	6 Seepage pit	9 Feedyard	12 Fertilizer storage	16 Other (specify below)
			13 Insecticide storage	

Direction from well?

How many feet?

FROM	TO	LITHOLOGIC LOG	FROM	TO	PLUGGING INTERVALS
0	10	Silt, some clay, damp, soft, tr. plastic, Brown			
10	15	Sand (f), damp, loose, well graded, Pale Brown			
15	20	Sand (f-m), damp, medium, Lt. Yellowish Bro			
20	21	Sand (f), damp, medium, poorly graded, Gray			
21	25	Sand (m-f), damp, well graded, Brown			
25	26	Sand (f-c), moist, well graded, Grayish Brown			
26	30	As above, wet,			
30	35	Sand (m-c), wet, medium, well graded, Dark G			
					MW-8S , Abovegrade
					Project Name: BM - Quaker Oats
					GeoCore # 1174 , #

7 CONTRACTOR'S OR LANDOWNER'S CERTIFICATION: This water well was **(1)** constructed, (2) reconstructed, or (3) plugged under my jurisdiction and was completed on (mo/day/year) **1/8/2007** and this record is true to the best of my knowledge and belief.

Kansas Water Well Contractor's License No. **527**. This Water Well Record was completed on (mo/day/yr) **2/6/07** under the business name of **GeoCore, Inc.** by (signature) *Dale Bell*