WATER WELL PLUGGING RECORD Form WWC-5P KSA 82a-1212 ID NO. MW-8

1 LOCATION OF WATER WELL:	Fraction	Section Number	Township Number	Range Number
County: Riley	NE¼ NE ¼ NE ¼	18	10S	8E E/W

Distance and direction from nearest town or city street address of well if located within city?
917 N. 3rd, Manhattan, Kansas

2 WATER WELL OWNER: KDHE T&M (Rex's Tire Company)
RR #, St. Address, Box #: 1000 SW Jackson #410
City, State, ZIP Code: Topeka, Ks 66612-1367
Board of Agriculture, Division of Water Resources Application Number:

3 MARK WELL'S LOCATION WITH AN "X" IN SECTION BOX:

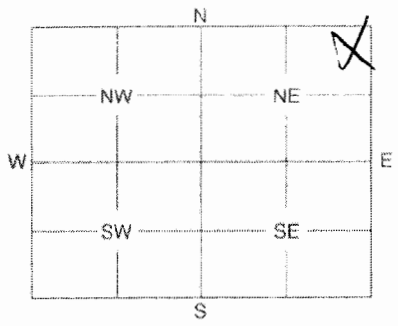

4 DEPTH OF WELL 20.00 ft.
WELL'S STATIC WATER LEVEL 18.16 ft
WELL WAS USED AS:
1 Domestic 2 Irrigation 3 Feedlot 4 Industrial 5 Public Water Supply 6 Oil Field Water Supply 7 Domestic (Lawn & Garden) 8 Air Conditioning 9 Dewatering (10) Monitoring Well 11 Injection Well 12 Other
Was a chemical / bacteriological sample submitted to Department? Yes ____ No X
If yes, mo/day/yr sample was submitted ____
Water Well Disinfected: Yes ____ No X

5 TYPE OF BLANK CASING USED:
1 Steel (2) PVC 3 RMP (SR) 4 ABS 5 Wrought 6 Asbestos-Cement 7 Fiberglass 8 Concrete Tile 9 Other (Specify below)
Blank casing diameter 4 in. Was casing pulled? Yes X No ____ If yes, how much NA
Casing height above or below land surface ____ in

6 GROUT PLUG MATERIAL: 1 Neat cement 2 Cement grout (3) Bentonite (4) Other Surface silts and clays
Grout Plug Intervals: From 20 ft. to 3 ft., From 3 ft. to 0 ft., From ____ ft. to ____ ft.
What is the nearest source of possible contamination:
1 Septic tank 2 Sewer lines 3 Watertight sewer lines 4 Lateral lines 5 Cess pool 6 Seepage pit 7 Pit privy 8 Sewage lagoon 9 Feedyard 10 Livestock pens 11 Fuel storage 12 Fertilizer storage 13 Insecticide storage 14 Abandoned water well 15 Oil well/Gas well (16) Other (specify below) Contsite
Direction from well? ____ How many feet? ____

FROM	TO	PLUGGING MATERIALS
20	3	Bentonite
3	0	Surface silts/clays

7 CONTRACTOR'S OR LANDOWNER'S CERTIFICATION: This water well was plugged under my jurisdiction and was completed on (mo/day/year) 05/17/07 and this record is true to the best of my knowledge and belief. Kansas Water Well Contractor's License No. 585 This Water Well Record was completed on (mo/day/year) 05/24/07 under the business name of Associated Environmental, Inc. by (signature) B. Johnson

INSTRUCTIONS: Use typewriter or ball point pen. Please press firmly and print clearly. Please fill in blanks, underline or circle the correct answers. Send top three copies to Kansas Department of Health and Environment, Bureau of Water, Geology Section, 1000 SW Jackson St., Ste. 420, Topeka, Kansas 66612-1367. Telephone: 785/296-5522. Send one to Water Well Owner and retain one for your records.