

Corrected

WATER WELL PLUGGING RECORD

Form WWC-5P

KSA 82a-1212

ID No.


PMW-1

1 LOCATION OF WATER WELL: Fraction *SE 1/4 NE 1/4 NE 1/4* Section Number *18* Township Number *10* Range Number *8 E*
 County: *Riley*

Distance and direction from nearest town or city street address of well if located within city?
720 N 3rd Manhattan, KS

2 WATER WELL OWNER: *Coastal Mart 9131* Board of Agriculture, Division of Water Resources
 RR#, St. Address, Box #: *Rt 130 @ 295* Application Number:
 City, State, ZIP Code: *Westville, NJ*

3 MARK WELL'S LOCATION WITH AN 'X' IN SECTION BOX:

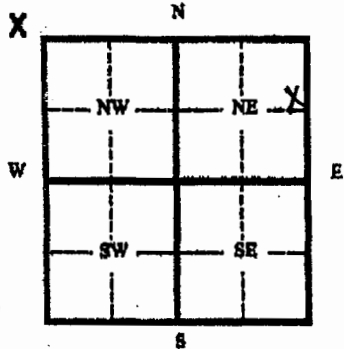

4 DEPTH OF WELL *24* ft.

WELL'S STATIC WATER LEVEL *20.5* ft.

- WELL WAS USED AS:
- 1 Domestic
 - 2 Irrigation
 - 3 Feedlot
 - 4 Industrial
 - 5 Public Water Supply
 - 6 Oil Field Water Supply
 - 7 Lawn and Garden (domestic)
 - 8 Air Conditioning
 - 9 Dewatering
 - 10 Monitoring Well
 - 11 Injection Well
 - 12 Other

Was a chemical/bacteriological sample submitted to Department? Yes ___ No ___
 If yes, mo/day/yr sample was submitted _____
 Water Well Disinfected: Yes ___ No ___

5 TYPE OF BLANK CASING USED:
 1 Steel 3 RMP (SR) 5 Wrought 7 Fiberglass 9 Other (specify below)
 2 PVC 4 ABC 6 Asbestos-Cement 8 Concrete Tile
 Blank casing diameter *2* in. Was casing pulled? Yes X No ___ If yes, how much *overdrilled to 20'*
 Casing height above or below land surface _____ in.

6 GROUT PLUG MATERIAL: 1 Neat cement 2 Cement grout 3 Bentonite 4 Other _____
 Grout Plug Intervals From *0* ft. to *24* ft. From _____ ft. to _____ ft. From _____ ft. to _____ ft.

- What is the nearest source of possible contamination:
- 1 Septic tank
 - 2 Sewer lines
 - 3 Watertight sewer lines
 - 4 Lateral lines
 - 5 Cess Pool
 - 6 Seepage pit
 - 7 Pit privy
 - 8 Sewage lagoon
 - 9 Feedyard
 - 10 Livestock pens
 - 11 Fuel storage
 - 12 Fertilizer storage
 - 13 Insecticide storage
 - 14 Abandoned water well
 - 15 Oil well/ Gas well
 - 16 Other (specify below) _____

Direction from well? _____ How many feet? _____

FROM	TO	CODE	PLUGGING MATERIALS
<i>0</i>	<i>24</i>		<i>Bentonite</i>

RECEIVED

JAN 08 2009

BUREAU OF WATER

7 CONTRACTOR'S OR LANDOWNER'S CERTIFICATION: This water well was plugged under my jurisdiction and was completed on (mo/day/yr) *8/21/06* and this record is true to the best of my knowledge and belief. Kansas Water Well Contractor's License No. *554* This Water Well Record was completed on (mo/day/yr) *10/6/06* under the business name of *Woofter Pump & Well / Blue-ken* by (signature) *[Signature]*

INSTRUCTIONS: Please fill in blanks and circle the correct answers. Send three copies to Kansas Department of Health and Environment, Bureau of Water, 1000 S W Jackson St., Ste. 420, Topeka, Kansas 66620-0001. Telephone: 785-296-3555. Send one to Water Well Owner and retain one for your records.