

WATER WELL PLUGGING RECORD Form WWC-5P

KSA 82a-1212

ID NO.

MW-8

1 LOCATION OF WATER WELL: Fraction Section Number Township Number Range Number
 Riley County SE ¼ SW ¼ SW ¼ 18 10 S R 8 E

Distance and direction from nearest town or city street address of well if located within city?
 Well was located at 1709 Ft. Riley Blvd. Manhattan KS.

2 WATER WELL OWNER:

Moo To You Inc.
 RR#, St. Address, Box #:
 PO Box 4119
 City, State ZIP Code:
 Wichita KS 67204

Global Positioning Systems (decimal degrees, min. of 4 digits)

Latitude: _____


Longitude: _____

Elevation: _____

Datum: _____

Data Collection Method: _____

3 MARK WELL'S LOCATION WITH AN "X" IN SECTION BOX:

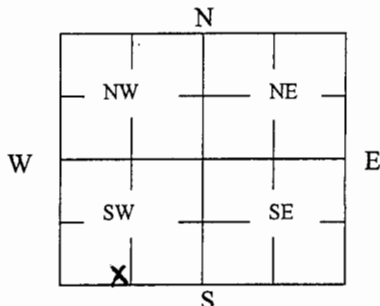

4 DEPTH OF WELL 30.5 ft.

WELL'S STATIC WATER LEVEL 15.97 ft

WELL WAS USED AS:

- 1 Domestic
 2 Irrigation
 3 Feedlot
 4 Industrial

- 5 Public Water Supply
 6 Oil Field Water Supply
 7 Domestic (Lawn & Garden)
 8 Air Conditioning

- 9 Dewatering
 10 Monitoring
 11 Injection Well
 12 Other _____

Was a chemical/bacteriological sample submitted to Department? Yes _____ No x _____

RECEIVED

OCT 06 2009

BUREAU OF
ENVIRONMENTAL REMEDIATION

5 TYPE OF BLANK CASING USED:

- 1 Steel 3 RMP (SR) 5 Wrought 7 Fiberglass 9 Other (Specify below)
 2 PVC 4 ABS 6 Asbestos-Cement 8 Concrete Tile

Blank casing diameter 2 in. Was casing pulled? Yes x No _____ If yes, how much 3 FT _____
 Casing height above or below land surface _____ in.

6 GROUT PLUG MATERIAL:

- 1 Neat cement 2 Cement grout 3 Bentonite 4 Other Soil _____

Grout Plug Intervals: From 3 ft. to 25.5 ft., From 0 ft. to 3 ft., From _____ to _____ ft.

What is the nearest source of possible contamination:

- 1 Septic tank 6 Seepage pit 11 Fuel Storage 16 Other (specify below)
 2 Sewer lines 7 Pit privy 12 Fertilizer storage
 3 Watertight sewer lines 8 Sewage lagoon 13 Insecticide storage
 4 Lateral lines 9 Feedyard 14 Abandoned water well
 5 Cess pool 10 Livestock pens 15 Oil well/Gas well

Direction from well? SW

How many feet? 50 ft

FROM	TO	PLUGGING MATERIALS	FROM	TO	PLUGGING MATERIALS
0	3	Soil			
3	25.5	Bentonite			

7 CONTRACTOR'S OR LANDOWNER'S CERTIFICATION: This water well was plugged under my jurisdiction and was completed on (mo/day/year) 10/5/2009 and this record is true to the best of my knowledge and belief. Kansas Water Well Contractor's License No. 585. This Water Well Record was completed on (mo/day/year) 10/5/2009 under the business name of Associated Environmental, Inc. by (signature) *Bruce Johnson*

INSTRUCTIONS: Use typewriter or ballpoint pen. Please press firmly and print clearly. Please fill in blanks, underline or circle the correct answers. Send top three copies to Kansas Department of Health and Environment, Bureau of Water, Geology Section, 1000 SW Jackson St., Ste. 420, Topeka, Kansas 66612-1367. Telephone: 785/296-5522. Send one to Water Well Owner and retain one for your records. Visit us at <http://www.kdheks.gov/waterwell/index.html>.