USE TYPEWRITER OR BALL POINT PEN-PRESS FIRMLY, PRINT CLEARLY.

WATER WELL RECORD
KSA 82a-1201-1215

Kansas Department of Health and Environment-Division of Environment
(Water well Contractors)
Topeka, Kansas 66620

1. Location of well:	County	Fraction	Section number	Township number	Range number
	Pottawatomie	SE 1/4 SE 1/4 SW 1/4	2	T 10 S	R 8 E E/W

2. Distance and direction from nearest town or city: Manhattan 14 Hiway 3 M. east 1 NORTH ½ east N side
Street address of well location if in city:

3. Owner of well: Tom Ubel
R.R. or street: R.R.5
City, state, zip code: Manhattan Kans

4. Locate with "X" in section below:

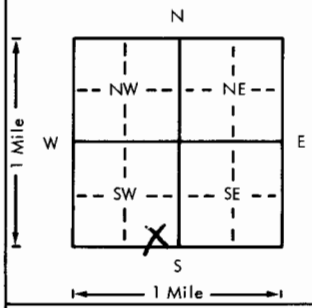

Sketch map:

6. Bore hole dia. 10 in. Completion date 11-6-78
Well depth 82 ft.

7. X Cable tool __ Rotary __ Driven __ Dug
__ Hollow rod __ Jetted __ Bored __ Reverse rotary

8. Use: X Domestic __ Public supply __ Industry
__ Irrigation __ Air conditioning __ Stock
__ Lawn __ Oil field water __ Other

9. Casing: Material STEEL Height: Above or below
Threaded X Welded ___ Surface 30 in.
RMP ___ PVC X Weight ___ lbs./ft.
Dia. 7" in. to 77 ft. depth Wall Thickness or gage No. .272 Wall
Dia. 5 in. to 82 ft. depth Wall Thickness or gage No. .267 Wall
steel

10. Screen: Manufacturer's name M.P.I.
Type P.V.C. Dia. 5"
Slot/~~gauge~~ .040 Length 10'
Set between 72 ft. and 82 ft.
___ ft. and ___ ft.
Gravel pack? X Size range of material ⅛ X ¼

11. Static water level:
57 ft. below land surface Date 11-6-78 mo./day/yr.

12. Pumping level below land surfaces:
___ ft. after ___ hrs. pumping ___ g.p.m.
___ ft. after ___ hrs. pumping ___ g.p.m.
Estimated maximum yield ~~10~~ 9 g.p.m.

13. Water sample submitted: mo./day/yr.
__ Yes X No Date

14. Well head completion: NA
__ Pitless adapter ___ Inches above grade

15. Well grouted? X 1-2
With: __ Neat cement __ Bentonite X Concrete
Depth: From 24 ft. to 10 ft.

16. Nearest source of possible contamination:
ft. 500 Direction NORTH Type Creek
Well disinfected upon completion? X Yes __ No

17. Pump: X Not installed
Manufacturer's name
Model number ___ HP ___ Volts ___
Length of drop pipe ___ ft. capacity ___ g.p.m.
Type:
__ Submersible __ Turbine
__ Jet __ Reciprocating
__ Centrifugal __ Other

5. Type and color of material

	From	To
top soil	0	2
Clay, Sandy	2	36
Sand Fine	36	48
Sand Fine	48	77
Gravel Water	77	82

(Use a second sheet if needed)

18. Elevation:
Topography:
X Hill
__ Slope
__ Upland
__ Valley

19. Remarks:

20. Water well contractor's certification:
This well was drilled under my jurisdiction and this report is true to the best of my knowledge and belief.
Business name Strader Drilling Co. License No. 237
Address Blue Rapids
Signed Harold Strader Date 11-6
Authorized representative

T 10 R 8 E/W Sec 2 1/4 1/4 1/4 1/4 SE SE SW

Forward the white, blue and pink copies to the Department of Health and Environment

Form WWC-5

MI-1023