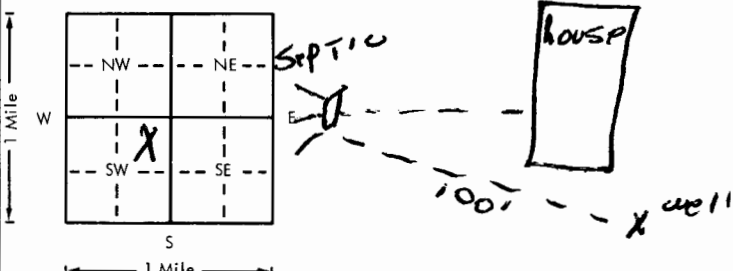


USE TYPEWRITER OR BALL POINT PEN—PRESS FIRMLY, PRINT CLEARLY.

WATER WELL RECORD
KSA 82a-1201-1215

Kansas Department of Health and Environment—Division of Environment
(Water well Contractors)
Topeka, Kansas 66620

1. Location of well: County POTAWATOMIE Fraction NE 1/4 NE 1/4 SW 1/4 Section number 10 Township number T 10 S R 8 E/W Range number 8	
2. Distance and direction from nearest town or city: 2 E OF MANHATTAN Street address of well location if in city: MANHATTAN	
3. Owner of well: RAY EMSLEY R.R. or street: RR 4 City, state, zip code: MANHATTAN, KS 66502	
4. Locate with "X" in section below: Sketch map: 	
5. Type and color of material	
TOP SOIL	From 0 To 6
Clay, sandy	From 6 To 21
FINE SAND	From 21 To 30
FINE SAND, COARSE SAND, GRAVEL, WATER BEARING	From 30 To 90
6. Bore hole dia. 12 in. Completion date 7-7-79 Well depth 40 ft.	
7. Cable tool <input checked="" type="checkbox"/> Rotary <input type="checkbox"/> Driven <input type="checkbox"/> Dug <input type="checkbox"/> Hollow rod <input type="checkbox"/> Jetted <input type="checkbox"/> Bored <input type="checkbox"/> Reverse rotary	
8. Use: <input checked="" type="checkbox"/> Domestic <input type="checkbox"/> Public supply <input type="checkbox"/> Industry <input type="checkbox"/> Irrigation <input type="checkbox"/> Air conditioning <input type="checkbox"/> Stock <input type="checkbox"/> Lawn <input type="checkbox"/> Oil field water <input type="checkbox"/> Other	
9. Casing: Material PVC Height: Above or below Threading: <input type="checkbox"/> Welded <input type="checkbox"/> Surface 34 in. RMP: <input type="checkbox"/> PVC 9L Weight 2.82 lbs./ft. Dia. 5 in. to 40 ft. depth Wall Thickness: inches or Dia. <input type="checkbox"/> in. to <input type="checkbox"/> ft. depth gage No. 135B	
10. Screen: Manufacturer's name Pumpco MPI Type PVC Dia. 5 Slot/gauze 020 Length 10 Set between 30 ft. and 40 ft. ft. and <input type="checkbox"/> ft. Gravel pack? <input checked="" type="checkbox"/> Size range of materials 030x.060	
11. Static water level: 18 ft. below land surface Date 7-7-79 mo./day/yr.	
12. Pumping level below land surfaces: <input type="checkbox"/> ft. after <input type="checkbox"/> hrs. pumping <input type="checkbox"/> g.p.m. <input type="checkbox"/> ft. after <input type="checkbox"/> hrs. pumping <input type="checkbox"/> g.p.m. Estimated maximum yield 30 g.p.m.	
13. Water sample submitted: <input type="checkbox"/> Yes <input checked="" type="checkbox"/> No Date <input type="checkbox"/> mo./day/yr.	
14. Well head completion: CAP <input type="checkbox"/> Pitless adapter 24 inches above grade	
15. Well grouted? <input checked="" type="checkbox"/> With: <input checked="" type="checkbox"/> Neat cement <input type="checkbox"/> Bentonite <input type="checkbox"/> Concrete Depth: From 5 ft. to 15 ft.	
16. Nearest source of possible contamination: 100 ft. Direction W Type SEPTIC Well disinfected upon completion? <input checked="" type="checkbox"/> Yes <input type="checkbox"/> No	
17. Pump: <input checked="" type="checkbox"/> Not installed Manufacturer's name _____ Model number _____ HP _____ Volts _____ Length of drop pipe _____ ft. capacity _____ g.p.m. Type: <input type="checkbox"/> Submersible <input type="checkbox"/> Turbine <input type="checkbox"/> Jet <input type="checkbox"/> Reciprocating <input type="checkbox"/> Centrifugal <input type="checkbox"/> Other	
(Use a second sheet if needed)	
18. Elevation: Topography: <input type="checkbox"/> Hill <input type="checkbox"/> Slope <input type="checkbox"/> Upland <input checked="" type="checkbox"/> Valley	19. Remarks: OWNER TO INSTALL SLAB
20. Water well contractor's certification: This well was drilled under my jurisdiction and this report is true to the best of my knowledge and belief. STRADER DRILG Co Inc. 182 Business name _____ License No. _____ Address 271 Holton, KS Signed Dale Robson Date 7-10-79 Authorized representative	

T
R
W
S
E
10-80-10 NE 1/4 SW