


1 LOCATION OF WATER WELL: Fraction NC 1/4 NE 1/4 SE 1/4 Section Number 10 Township Number T 10 S Range Number R 8 E2N

Distance and direction from nearest town or city street address of well if located within city? From Manhattan Mo 4.5 miles East on 24 to Excel Road then go 1/2 mile South + 1/2 mile West

2 WATER WELL OWNER: Tye Dawson
 RR#, St. Address, Box #: 3560 Excel Rd. Board of Agriculture, Division of Water Resources
 City, State, ZIP Code: Manhattan, Kansas 66502 Application Number:

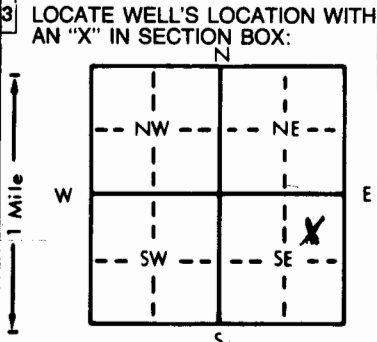

4 DEPTH OF COMPLETED WELL: 52 ft. ELEVATION: ft.
 Depth(s) Groundwater Encountered 1. 25 ft. 2. ft. 3. ft.
 WELL'S STATIC WATER LEVEL 25 ft. below land surface measured on mo/day/yr
 Pump test data: Well water was ft. after hours pumping gpm
 Est. Yield 60 gpm: Well water was ft. after hours pumping gpm
 Bore Hole Diameter 10 in. to 54 ft., and in. to ft.
 WELL WATER TO BE USED AS: 5 Public water supply 8 Air conditioning 11 Injection well
 1 Domestic 3 Feedlot 6 Oil field water supply 9 Dewatering 12 Other (Specify below)
 2 Irrigation 4 Industrial 7 Lawn and garden only 10 Monitoring well
 Was a chemical/bacteriological sample submitted to Department? Yes.....No.....; If yes, mo/day/yr sample was submitted
 Water Well Disinfected? Yes No

5 TYPE OF BLANK CASING USED: 5 Wrought iron 8 Concrete tile CASING JOINTS: Glued Clamped
 2 PVC 3 RMP (SR) 6 Asbestos-Cement 9 Other (specify below) Welded Serruled
 4 ABS 7 Fiberglass Threaded.....

Blank casing diameter 5 in. to 3.2 ft., Dia in. to ft., Dia in. to ft.
 Casing height above land surface 21 in., weight 54.40 lbs./ft. Wall thickness or gauge No.

TYPE OF SCREEN OR PERFORATION MATERIAL: 7 PVC 10 Asbestos-cement
 1 Steel 3 Stainless steel 5 Fiberglass 8 RMP (SR) 11 Other (specify)
 2 Brass 4 Galvanized steel 6 Concrete tile 9 ABS 12 None used (open hole)

SCREEN OR PERFORATION OPENINGS ARE: 5 Gauzed wrapped 8 Saw cut 11 None (open hole)
 1 Continuous slot 3 Mill slot 16/1000's 6 Wire wrapped 9 Drilled holes
 2 Louvered shutter 4 Key punched 7 Torch cut 10 Other (specify)

SCREEN-PERFORATED INTERVALS: From 32 ft. to 52 ft., From ft. to ft.
 GRAVEL PACK INTERVALS: From 20 ft. to 52 ft., From ft. to ft.

6 GROUT MATERIAL: 1 Neat cement 2 Cement grout 3 Bentonite 4 Other
 Grout Intervals: From 0 ft. to 20 ft., From ft. to Erroneously ft. to ft.
 What is the nearest source of possible contamination:
 1 Septic tank 4 Lateral lines 7 Pit privy 10 Livestock pens 14 Abandoned water well
 2 Sewer lines 5 Cess pool 8 Sewage lagoon 11 Fuel storage 15 Oil well/Gas well
 3 Watertight sewer lines 6 Seepage pit 9 Feedyard 12 Fertilizer storage 16 Other (specify below)
 13 Insecticide storage
 Direction from well? EAST How many feet? 100'

FROM	TO	LITHOLOGIC LOG	FROM	TO	PLUGGING INTERVALS
0	22	CLAY SANDY			
22	27	FINE SAND			
27	42	MEDIUM SAND			
42	52	COURSE SAND			

7 CONTRACTOR'S OR LANDOWNER'S CERTIFICATION: This water well was (1) constructed, (2) reconstructed, or (3) plugged under my jurisdiction and was completed on (mo/day/year) 8/29/88 and this record is true to the best of my knowledge and belief. Kansas Water Well Contractor's License No. 451 This Water Well Record was completed on (mo/day/yr) 9/29/88 under the business name of Haldeman Well Drilling by (signature) Craig Haldeman

OFFICE USE ONLY
T 10 R 8 E2N
SEC. 10