


1 LOCATION OF WATER WELL: County: Polawanie Fraction: SE 1/4 SW 1/4 SW 1/4 Section Number: 10 Township Number: T 10 S Range Number: R 8 E

Distance and direction from nearest town or city street address of well if located within city?
2 mi E of Manhattan 300' south of 24 hi

2 WATER WELL OWNER: Glavens Const Co
 RR#, St. Address, Box #: 1015 E hi H Liberty Mo. 64068
 City, State, ZIP Code: 1015 E hi H Liberty Mo. 64068
 Board of Agriculture, Division of Water Resources Application Number: 910261

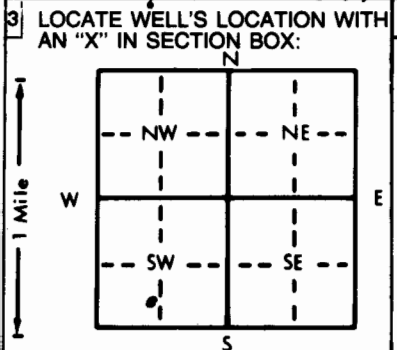

4 DEPTH OF COMPLETED WELL: 60' ft. ELEVATION: _____ ft.
 Depth(s) Groundwater Encountered 1. 31' ft. 2. _____ ft. 3. _____ ft.
 WELL'S STATIC WATER LEVEL 28' ft. below land surface measured on mo/day/yr 8, 20, 91
 Pump test data: Well water was 30' ft. after 48 hours pumping 1500 gpm
 Est. Yield _____ gpm: Well water was _____ ft. after _____ hours pumping _____ gpm
 Bore Hole Diameter: 30" in. to 60" ft., and _____ in. to _____ ft.
 WELL WATER TO BE USED AS:
 5 Public water supply 8 Air conditioning 11 Injection well
 1 Domestic 3 Feedlot 6 Oil field water supply 9 Dewatering 12 Other (Specify below)
 2 Irrigation 4 Industrial 7 Lawn and garden only 10 Observation well
 Was a chemical/bacteriological sample submitted to Department? Yes _____ No _____; If yes, mo/day/yr sample was submitted _____
 Water Well Disinfected? Yes No _____

5 TYPE OF BLANK CASING USED:
 1 Steel 3 RMP (SR) 5 Wrought iron 8 Concrete tile CASING JOINTS: Glued _____ Clamped _____
 2 PVC 4 ABS 6 Asbestos-Cement 9 Other (specify below) Welded
 7 Fiberglass Threaded _____
 Blank casing diameter 16 in. to 20 ft., Dia _____ in. to _____ ft., Dia _____ in. to _____ ft.
 Casing height above land surface _____ in., weight _____ lbs./ft. Wall thickness or gauge No. _____
 TYPE OF SCREEN OR PERFORATION MATERIAL:
 1 Steel 3 Stainless steel 5 Fiberglass 7 PVC 10 Asbestos-cement
 2 Brass 4 Galvanized steel 6 Concrete tile 8 RMP (SR) 11 Other (specify) _____
 9 ABS 12 None used (open hole)
 SCREEN OR PERFORATION OPENINGS ARE:
 1 Continuous slot 3 Mill slot 5 Gauzed wrapped 8 Saw cut 11 None (open hole)
 2 Louvered shutter 4 Key punched 6 Wire wrapped 9 Drilled holes
 7 Torch cut 10 Other (specify) _____
 SCREEN-PERFORATED INTERVALS: From 20 ft. to 60 ft., From _____ ft. to _____ ft.
 From _____ ft. to _____ ft., From _____ ft. to _____ ft.
 GRAVEL PACK INTERVALS: From 15 ft. to 60 ft., From _____ ft. to _____ ft.
 From _____ ft. to _____ ft., From _____ ft. to _____ ft.

6 GROUT MATERIAL: 1 Neat cement 2 Cement grout 3 Bentonite 4 Other _____
 Grout Intervals: From SURFACE ft. to 15 ft., From _____ ft. to _____ ft., From _____ ft. to _____ ft.
 What is the nearest source of possible contamination:
 1 Septic tank 4 Lateral lines 7 Pit privy 10 Livestock pens 14 Abandoned water well
 2 Sewer lines 5 Cess pool 8 Sewage lagoon 11 Fuel storage 15 Oil well/Gas well
 3 Watertight sewer lines 6 Seepage pit 9 Feedyard 12 Fertilizer storage 16 Other (specify below)
 13 Insecticide storage _____
 Direction from well? _____ How many feet? _____

FROM	TO	LITHOLOGIC LOG	FROM	TO	LITHOLOGIC LOG
0	31	stiff dark brown clay			
31	60	medium coarse brown sand			
		Well # 2			

7 CONTRACTOR'S OR LANDOWNER'S CERTIFICATION: This water well was (1) constructed, (2) reconstructed, or (3) plugged under my jurisdiction and was completed on (mo/day/year) 8 20 91 and this record is true to the best of my knowledge and belief. Kansas Water Well Contractor's License No. 392 This Water Well Record was completed on (mo/day/yr) 8 31 91 under the business name of Ray L. Dilling Cochr. by (signature) Ray L. Dilling