

1 LOCATION OF WATER WELL: Fraction NW 1/4 SW 1/4 SW 1/4 Section Number 10 Township Number T 10 S Range Number R 8 E

Distance and direction from nearest town or city street address of well if located within city?

8419 E. Highway 24

2 WATER WELL OWNER: Leisure Acres RR#, St. Address, Box #: 8419 E. Highway 24 KA 66502 Board of Agriculture, Division of Water Resources Application Number: 18934-00043793 City, State, ZIP Code: MANHATTAN, KS 66502

3 LOCATE WELL'S LOCATION WITH AN "X" IN SECTION BOX: [Diagram showing a 36x36 section grid with 'X' in the NW corner]

4 DEPTH OF COMPLETED WELL: 60 ft. ELEVATION: [Blank] ft.

Depth(s) Groundwater Encountered 1. [Blank] ft. 2. [Blank] ft. 3. [Blank] ft.

WELL'S STATIC WATER LEVEL: 27 ft. below land surface measured on mo/day/yr

Pump test data: Well water was [Blank] ft. after [Blank] hours pumping [Blank] gpm

Est. Yield [Blank] gpm: Well water was [Blank] ft. after [Blank] hours pumping [Blank] gpm

Bore Hole Diameter [Blank] in. to [Blank] ft., and [Blank] in. to [Blank] ft.

WELL WATER TO BE USED AS: 5 Public water supply 8 Air conditioning 11 Injection well
1 Domestic 3 Feedlot 6 Oil field water supply 9 Dewatering 12 Other (Specify below)
2 Irrigation 4 Industrial 7 Lawn and garden only 10 Monitoring well

Was a chemical/bacteriological sample submitted to Department? Yes [Blank] No [X]; If yes, mo/day/yr sample was submitted

Water Well Disinfected? Yes [X] No [Blank]

5 TYPE OF BLANK CASING USED: 1 Steel 3 RMP (SR) 5 Wrought iron 8 Concrete tile CASING JOINTS: Glued [Blank] Clamped [Blank]
2 PVC 4 ABS 6 Asbestos-Cement 9 Other (specify below) Welded [Blank]
7 Fiberglass Threaded [Blank]

Blank casing diameter 16 in. to [Blank] ft., Dia. [Blank] in. to [Blank] ft., Dia. [Blank] in. to [Blank] ft.

Casing height ~~land surface~~ 36 in., weight [Blank] lbs./ft. Wall thickness or gauge No. [Blank]

TYPE OF SCREEN OR PERFORATION MATERIAL: 7 PVC 10 Asbestos-cement
1 Steel 3 Stainless steel 5 Fiberglass 8 RMP (SR) 11 Other (specify) N/A
2 Brass 4 Galvanized steel 6 Concrete tile 9 ABS 12 None used (open hole)

SCREEN OR PERFORATION OPENINGS ARE: 5 Gauzed wrapped 8 Saw cut 11 None (open hole)
1 Continuous slot 3 Mill slot 6 Wire wrapped 9 Drilled holes
2 Louvered shutter 4 Key punched 7 Torch cut 10 Other (specify) N/A

SCREEN-PERFORATED INTERVALS: From [Blank] ft. to [Blank] ft., From [Blank] ft. to [Blank] ft.


GRAVEL PACK INTERVALS: From [Blank] ft. to [Blank] ft., From [Blank] ft. to [Blank] ft.

6 GROUT MATERIAL: 1 Neat cement 2 Cement grout 3 Bentonite 4 Other [Blank]

Grout Intervals: From 27 ft. to 3 ft., From [Blank] ft. to [Blank] ft., From [Blank] ft. to [Blank] ft.

What is the nearest source of possible contamination: 10 Livestock pens 14 Abandoned water well
1 Septic tank 4 Lateral lines 7 Pit privy 11 Fuel storage 15 Oil well/Gas well
2 Sewer lines 5 Cess pool 8 Sewage lagoon 12 Fertilizer storage 16 Other (specify below)
3 Watertight sewer lines 6 Seepage pit 9 Feedyard 13 Insecticide storage NONE

Direction from well? How many feet? [Blank]

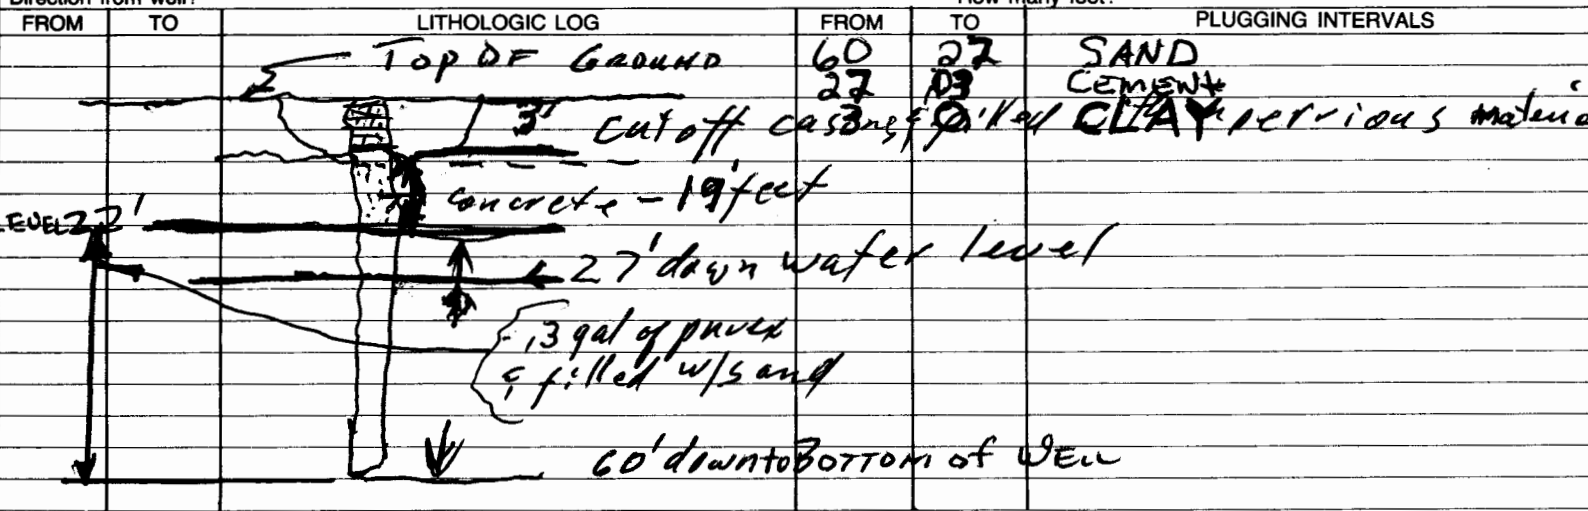

7 CONTRACTOR'S OR LANDOWNER'S CERTIFICATION: This water well was (1) constructed, (2) reconstructed, or (3) plugged under my jurisdiction and was completed on (mo/day/year) May 7, 1992 and this record is true to the best of my knowledge and belief. Kansas Water Well Contractor's License No. [Blank] This Water Well Record was completed on (mo/day/yr) May 10, 1992 under the business name of Leisure Acres by (signature) [Signature]