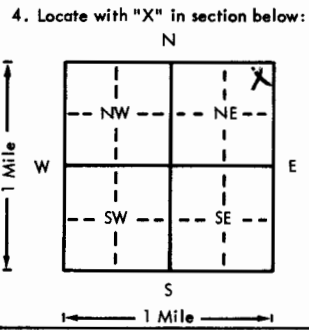


USE TYPEWRITER OR BALL POINT PEN—PRESS FIRMLY, PRINT CLEARLY.

WATER WELL RECORD
KSA 82a-1201-1215

Kansas Department of Health and Environment—Division of Environment
(Water well Contractors)
Topeka, Kansas 66620

1. Location of well: County <u>POTTAWATOMIE</u> Fraction <u>NE 1/4 NE 1/4 NE 1/4</u> Section number <u>11</u> Township number <u>T 10 S R 8</u> Range number <u>8</u> E/W	
2. Distance and direction from nearest town or city: <u>3 E, 5 S</u> Street address of well location if in city: <u>OF MANHATTAN</u>	
3. Owner of well: <u>RAY STEPHSON</u> R or streets: <u>R.R. ST. GEORGE</u> City, state, zip code: <u>MANHATTAN, KS. 66535</u>	
4. Locate with "X" in section below: Sketch map: 	
5. Type and color of material	
	From To
<u>TOP SOIL</u>	<u>0</u> <u>5</u>
<u>BROWN CLAY</u>	<u>5</u> <u>32</u>
<u>COURSE SAND - med. gr.</u>	<u>32</u> <u>45</u>
6. Bore hole dia. <u>10</u> in. Completion date <u>8-9-76</u> Well depth <u>45</u> ft.	
7. <input checked="" type="checkbox"/> Cable tool <input checked="" type="checkbox"/> Rotary <input type="checkbox"/> Driven <input type="checkbox"/> Dug <input type="checkbox"/> Hollow rod <input type="checkbox"/> Jetted <input type="checkbox"/> Bored <input type="checkbox"/> Reverse rotary	
8. Use: <input checked="" type="checkbox"/> Domestic <input type="checkbox"/> Public supply <input type="checkbox"/> Industry <input type="checkbox"/> Irrigation <input type="checkbox"/> Air conditioning <input type="checkbox"/> Stock <input type="checkbox"/> Lawn <input type="checkbox"/> Oil field water <input type="checkbox"/> Other	
9. Casing: Material <u>PVC</u> Height: <u>Above</u> or below Threaded <input type="checkbox"/> Welded <input type="checkbox"/> Surface <u>3 1/2</u> in. RMP <input type="checkbox"/> PVC <u>9L</u> Weight <u>2.58</u> lbs./ft. Dia. <u>5</u> in. to <u>45</u> ft. depth Wall Thickness: inches or Dia. <u>5</u> in. to <u>45</u> ft. depth gage No. <u>2.79</u>	
10. Screens: Manufacturer's name <u>PUMPEE</u> Type <u>PVC</u> Dia. <u>5</u> Slot gauge <u>1020</u> Length <u>7</u> Set between <u>38</u> ft. and <u>45</u> ft. ft. and <u>45</u> ft. Gravel pack? <input checked="" type="checkbox"/> Size range of material <u>0.30 x 0.60</u>	
11. Static water level: <u>22</u> ft. below land surface Date <u>8-9-76</u> mo./day/yr.	
12. Pumping level below land surfaces: <u>AIR TEST</u> <u> </u> ft. after <u> </u> hrs. pumping <u> </u> g.p.m. <u> </u> ft. after <u> </u> hrs. pumping <u> </u> g.p.m. Estimated maximum yield <u>30</u> g.p.m.	
13. Water sample submitted: <u> </u> mo./day/yr. Yes <input type="checkbox"/> No <input checked="" type="checkbox"/> Date <u> </u>	
14. Well head completion: <u>CAP</u> <u> </u> Pitless adapter <u>24</u> inches above grade	
15. Well grouted? <input checked="" type="checkbox"/> With: <input checked="" type="checkbox"/> Neat cement <input type="checkbox"/> Bentonite <input type="checkbox"/> Concrete Depth: From <u>5</u> ft. to <u>15</u> ft.	
16. Nearest source of possible contamination: <u>200</u> ft. Direction <u>E</u> Type <u>SEPTIC</u> Well disinfected upon completion? <input checked="" type="checkbox"/> Yes <input type="checkbox"/> No	
17. Pump: <u>Not installed</u> Manufacturer's name <u> </u> Model number <u> </u> HP <u> </u> Volts <u> </u> Length of drop pipe <u> </u> ft. capacity <u> </u> g.p.m. Type: <input type="checkbox"/> Submersible <input type="checkbox"/> Turbine <input type="checkbox"/> Jet <input type="checkbox"/> Reciprocating <input type="checkbox"/> Centrifugal <input type="checkbox"/> Other	
(Use a second sheet if needed)	
18. Elevation: Topography: <input type="checkbox"/> Hill <input type="checkbox"/> Slope <input type="checkbox"/> Upland <input checked="" type="checkbox"/> Valley	19. Remarks: <u>OWNER WILL INSTALL SLAB</u>
20. Water well contractor's certification: This well was drilled under my jurisdiction and this report is true to the best of my knowledge and belief. <u>STRADER DRUG CO INC 182</u> Business name License No. Address <u>RT 1 HOLTAN, KS</u> Signed <u>Paul Robinson</u> Date <u>8-9-76</u> Authorized representative	

T 10 S R 8 E/W 11 NE 1/4 NE 1/4