97c

USE TYPEWRITER OR BALL POINT PEN-PRESS FIRMLY, PRINT CLEARLY.

T R EW sec 1/4 1/4 1/4 No.

WATER WELL RECORD
KSA 82a-1201-1215

Kansas State Dept. Of Health
(Water Well Contractors)
Forbes-Bldg. 740
Topeka, Kansas 66620

1 Location of well:	County	Township name	Fraction	Section number	Town number	Range number
	Pottawatomie	Blue	TAC T. NE 1/4	17	10	8

Distance and direction from nearest town or city:

Street address of well location if in city:

3 Owner of well: RAY Steph. ~~EN~~SON

Address: St. George, KANS.

Locate with "X" in section below:

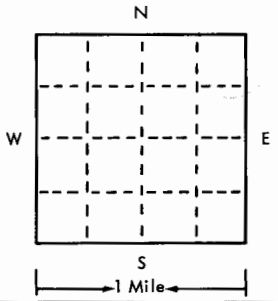

Sketch map:

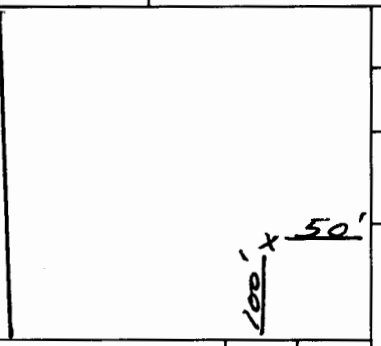

4 Well depth: 50 ft. Date of completion 2-18-75
Well diameter 10 in.

5 ☐ Cable tool ☒ Rotary ☐ Driven ☐ Dug
☐ Hollow rod ☐ Jetted ☐ Bored ☐ Reverse rotary

6 Use: ☒ Domestic ☐ Public supply ☐ Industry
☐ Irrigation ☐ Air conditioning ☐ Commercial
☐ Test well ☐

7 Casing: Material PVC Height: above/below
Threaded ☐ Welded ☐ Surface 24 in.
Diam. Weight 2.37 lbs./ft.
6 in. to 50 ft. depth Drive shoe? ☐ Yes ☒ No
___ in. to ___ ft. depth

2

Type and color of material	From	To
Top Soil	0	3
YELLOW CLAY	3	17
Fine Sand	17	35
Coarse Sand	35	40
Gravel	40	50
(use a second sheet if needed)		

8 Screen:
Manufacturer Pumpco
Type PVC Dia.
Slot/~~gauze~~ .025 Length 6'
Set between 44 ft. and 50 ft.
Fittings:
Gravel pack ☒ Yes ☐ No Size range of material #3

9 Static water level: NOT MEASURED
___ ft. below land surface Date

10 Pumping level below land surface: AIR TEST
___ ft. after ___ hrs. pumping ___ g.p.m.
___ ft. after ___ hrs. pumping ___ g.p.m.
Estimated maximum yield 30 g.p.m.

11 Water sample submitted:
☐ Yes ☒ No Date

12 Well head completion: capped
☐ Pitless adapter 24 ☐ Inches above grade

13 Well grouted? ☒ Yes ☐ No
☒ Neat cement ☐ Bentonite ☐
Depth: From 0 ft. to 10 ft.

14 Nearest source of possible contamination:
ft. 150 Direction EAST Type SEPTIC TANK
Well disinfected upon completion? ☒ Yes ☐ No

15 Pump: ☒ Not installed
Manufacturer's name
Model number HP Volts
Length of drop pipe ft. capacity g.m.p.
Type:
☐ Submersible ☐ Turbine
☐ Jet ☐ Reciprocating
☐ Certrifugal ☐ Other

16 Remarks: elevation
1010

Topography:
☐ Hill
☐ Slope
☐ Upland
☒ Valley

17 Water well contractor's certification:
This well was drilled under my jurisdiction and this report is true to the best of my knowledge and belief.
Strader Drilling Co. Inc. #182
Business name License No.
Address RR1-HY. 75N Holton, KANS.
Signed [signature] Date 2-22-75
Authorized representative

Forward the white, blue and pink copies to the Kansas State Dept. Of Health.

Form WWC-5