USE TYPEWRITER OR BALL POINT PEN-PRESS FIRMLY, PRINT CLEARLY.

T R EW sec 1/4 1/4 1/4 No.

WATER WELL RECORD
KSA 82a-1201-1215

Kansas State Dept. Of Health
(Water Well Contractors)
Forbes-Bldg. 740
Topeka, Kansas 66620

1 Location of well:	County	Township name	Fraction	Section number	Town number	Range number
	Pottawatomie	Blue	TRACT ¼ NE Corner	17	10	8

Distance and direction from nearest town or city:

Street address of well location if in city:

3 Owner of well: RAY Stephenson

Address: St. Geo., KANS.

Locate with "X" in section below:

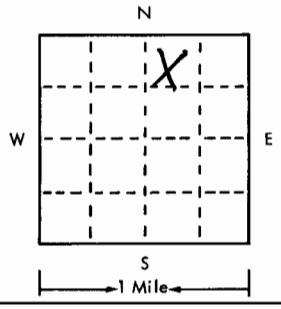

Sketch map:

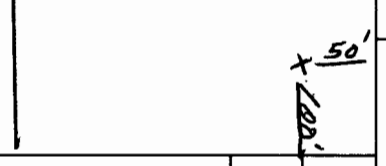

4 Well depth: 50 ft. Date of completion 2-18-75
Well diameter 10 in.

5 ☐ Cable tool ☒ Rotary ☐ Driven ☐ Dug
☐ Hollow rod ☐ Jetted ☐ Bored ☐ Reverse rotary

6 Use: ☒ Domestic ☐ Public supply ☐ Industry
☐ Irrigation ☐ Air conditioning ☐ Commercial
☐ Test well ☐

7 Casing: Material PVC Height: above/below
Threaded ☐ Welded ☐ Surface 24 in.
Diam. Weight 2.33 lbs./ft.
5 in. to 50 ft. depth Drive shoe? ☐ Yes ☒ No
___ in. to ___ ft. depth

2

Type and color of material	From	To
TOP Soil	0	5
Yellow Clay	5	19
Fine Sand	19	36
Coarse Sand	36	42
Gravel	42	50

(use a second sheet if needed)

8 Screen:
Manufacturer Pumpco
Type PVC Dia. 5"
Slot/~~gauge~~ 1080 Length 6'
Set between 44 ft. and 50 ft.
Fittings:
Gravel pack ☒ Yes ☐ No Size range of material 1/4 x 1/8

9 Static water level: NOT Measured
___ ft. below land surface Date ___

10 Pumping level below land surfaces: Air Test
___ ft. after ___ hrs. pumping ___ g.p.m.
___ ft. after ___ hrs. pumping ___ g.p.m.
Estimated maximum yield 30 g.p.m.

11 Water sample submitted:
☐ Yes ☒ No Date ___

12 Well head completion: Capped
☐ Pitless adapter 24 ☐ Inches above grade

13 Well grouted? ☒ Yes ☐ No
☒ Neat cement ☐ Bentonite ☐
Depth: From 0 ft. to 10 ft.

14 Nearest source of possible contamination:
ft. 150 Direction EAST Type S-T
Well disinfected upon completion? ☒ Yes ☐ No

15 Pump: ☒ Not installed
Manufacturer's name ___
Model number ___ HP ___ Volts ___
Length of drop pipe ___ ft. capacity ___ g.m.p.
Type:
☐ Submersible ☐ Turbine
☐ Jet ☐ Reciprocating
☐ Certrifugal ☐ Other

16 Remarks: elevation 1010

Topography:
☐ Hill
☐ Slope
☐ Upland
☒ Valley

17 Water well contractor's certification:
This well was drilled under my jurisdiction and this report is true to the best of my knowledge and belief.
Strader Drilling Co. Inc. #182
Business name License No.
Address RR1-Hy. 75 N Holton, KANS
Signed [signature] Date 2-28-75
Authorized representative

Forward the white, blue and pink copies to the Kansas State Dept. Of Health.

Form WWC-5