

**WATER WELL PLUGGING RECORD**

Form WWC-5P

KSA 82a-1212

ID No.


AS-1

1 LOCATION OF WATER WELL:	Fraction	Section Number	Township Number	Range Number
County: Riley	SE 1/4 NE 1/4 NE 1/4	18	10	8

Distance and direction from nearest town or city street address of well if located within city?  
809 North 3rd, Mahhattan, KS

2 WATER WELL OWNER: Town & Country #49  
RR#, St. Address, Box # PO Box 17087  
City, State, ZIP Code Wichita, KS  
Board of Agriculture, Division of Water Resources  
Application Number:

3 MARK WELL'S LOCATON WITH AN "X" IN SECTION BOX:

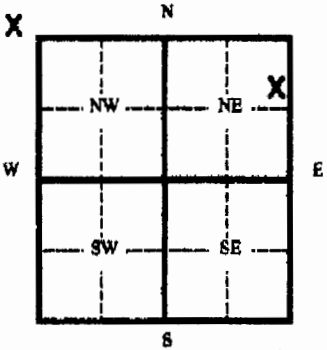

4 DEPTH OF WELL 32 ft.  
WELL'S STATIC WATER LEVEL \_\_\_\_\_ ft.  
WELL WAS USED AS:  
1 Domestic      5 Public Water Supply      9 Dewatering  
2 Irrigation      6 Oil Field Water Supply      10 Monitoring Well  
3 Feedlot      7 Lawn and Garden (domestic)      11 Injection Well  
4 Industrial      8 Air Conditioning      12 Other \_\_\_\_\_  
Was a chemical/bacteriological sample submitted to Department? Yes \_\_\_\_\_ No \_\_\_\_\_  
If yes, mo/day/yr sample was submitted \_\_\_\_\_  
Water Well Disinfected: Yes \_\_\_\_\_ No \_\_\_\_\_

5 TYPE OF BLANK CASING USED:  
1 Steel      3 RMP (SR)      5 Wrought      7 Fiberglass      9 Other (specify below)  
2 PVC      4 ABC      6 Asbestos-Cement      8 Concrete Tile  
Blank casing diameter 2 in. Was casing pulled? Yes  No \_\_\_\_\_ If yes, how much 3 feet  
Casing height above or below land surface \_\_\_\_\_ in.

6 GROUT PLUG MATERIAL: 1 Neat cement      2 Cement grout      3 Bentonite      4 Other \_\_\_\_\_  
Grout Plug Intervals From 0 ft. to 32 ft. From \_\_\_\_\_ ft. to \_\_\_\_\_ ft. From \_\_\_\_\_ ft. to \_\_\_\_\_ ft.  
What is the nearest source of possible contamination:  
1 Septic tank      6 Seepage pit      11 Fuel storage      16 Other (specify below)  
2 Sewer lines      7 Pit privy      12 Fertilizer storage  
3 Watertight sewer lines      8 Sewage lagoon      13 Insecticide storage  
4 Lateral lines      9 Feedyard      14 Abandoned water well  
5 Cess Pool      10 Livestock pens      15 Oil well/ Gas well  
Direction from well? \_\_\_\_\_ How many feet? \_\_\_\_\_

FROM	TO	CODE	PLUGGING MATERIALS
0	32		Bentonite chips

7 CONTRACTOR'S OR LANDOWNER'S CERTIFICATION: This water well was plugged under my jurisdiction and was completed on (mo/day/yr) 4/8/14 and this record is true to the best of my knowledge and belief. Kansas Water Well Contractor's License No. \_\_\_\_\_ This Water Well Record was completed on (mo/day/yr) 9/9/14 under the business name of Bluestem Environmental Engineering, Inc. by (signature) *Niddht*

INSTRUCTIONS: Please fill in blanks and circle the correct answers. Send three copies to Kansas Department of Health and Environment, Bureau of Water, 1000 S W Jackson St., Ste. 420, Topeka, Kansas 66620-0001. Telephone: 785-298-3585. Send one to Water Well Owner and retain one for your records.