WATER WELL PLUGGING RECORD Form WWC-5P KSA 82a-1212 ID No. SVE1

| 1 LOCATION OF WATER WELL: County: Riley | Fraction SE ¼ NE ¼ NE ¼ | Section Number 18 | Township Number 10 | Range Number 8 |
|---|---|---|---|---|

Distance and direction from nearest town or city street address of well if located within city?
809 North 3rd, Mahhattan, KS

2 WATER WELL OWNER: Town & Country #49
RR#, St. Address, Box # PO Box 17087
City, State, ZIP Code : Wichita, KS

Board of Agriculture, Division of Water Resources
Application Number:

3 MARK WELL'S LOCATON WITH AN "X" IN SECTION BOX:

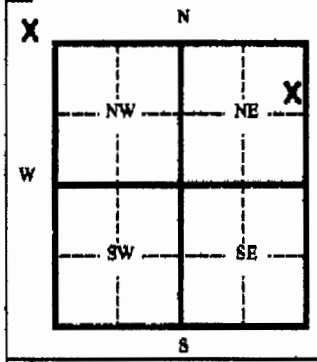


4 DEPTH OF WELL 22 ft.

WELL'S STATIC WATER LEVEL ..... ft.

WELL WAS USED AS:

1 Domestic 5 Public Water Supply 9 Dewatering
2 Irrigation 6 Oil Field Water Supply (10) Monitoring Well
3 Feedlot 7 Lawn and Garden (domestic) 11 Injection Well
4 Industrial 8 Air Conditioning 12 Other .....

Was a chemical/bacteriological sample submitted to Department? Yes .... No ....
If yes, mo/day/yr sample was submitted .....
Water Well Disinfected: Yes ..... No .....

5 TYPE OF BLANK CASING USED:

1 Steel 3 RMP (SR) 5 Wrought 7 Fiberglass 9 Other (specify below)
(2) PVC 4 ABC 6 Asbestos-Cement 8 Concrete Tile .....

Blank casing diameter 4 in. Was casing pulled? Yes X No ..... If yes, how much 3 feet

Casing height above or below land surface ..... in.

6 GROUT PLUG MATERIAL: 1 Neat cement 2 Cement grout (3) Bentonite 4 Other .....

Grout Plug Intervals From 0 ft. to 22 ft. From ..... ft. to ..... ft. From ..... ft. to ..... ft.

What is the nearest source of possible contamination:

1 Septic tank 6 Seepage pit (11) Fuel storage 16 Other (specify below)
2 Sewer lines 7 Pit privy 12 Fertilizer storage .....
3 Watertight sewer lines 8 Sewage lagoon 13 Insecticide storage
4 Lateral lines 9 Feedyard 14 Abandoned water well
5 Cess Pool 10 Livestock pens 15 Oil well/ Gas well

Direction from well? ..... How many feet? .....

| FROM | TO | CODE | PLUGGING MATERIALS |
|---|---|---|---|
| 0 | 22 | | Bentonite chips |
| | | | |
| | | | |
| | | | |
| | | | |
| | | | |
| | | | |

7 CONTRACTOR'S OR LANDOWNER'S CERTIFICATION: This water well was plugged under my jurisdiction and was completed on (mo/day/yr) 4/8/14 and this record is true to the best of my knowledge and belief. Kansas Water Well Contractor's License No. ..... This Water Well Record was completed on (mo/day/yr) 9/9/14 under the business name of Bluestem Environmental Engineering, Inc.
by (signature) .....

INSTRUCTIONS: Please fill in blanks and circle the correct answers. Send three copies to Kansas Department of Health and Environment, Bureau of Water, 1000 S W Jackson St., Ste. 420, Topeka, Kansas 66620-0001. Telephone: 785-296-3565. Send one to Water Well Owner and retain one for your records.

Form provided by Forms On-A-Disk, Inc. · Dallas, Texas · (214) 340-9429