

WATER WELL PLUGGING RECORD Form WWC-5P

KSA 82a-1212

ID NO.

NE Well #2


1 LOCATION OF WATER WELL: Fraction NW 1/4 SE 1/4 NW 1/4 SW 1/4 Section Number 17 Township Number T 10 S Range Number 8 E W
 County: Pottawatomie

Street/Rural Address of Well Location; if unknown, distance & direction from nearest town or intersection: If at owner's address, check here E. of Ft. Riley Blvd & S. of E. Poyntz
in Manhattan, Ks

Global Positioning Systems (GPS) information:
 Latitude: 39.179183 (in decimal degrees)
 Longitude: -96.554897 (in decimal degrees)
 Elevation: 1010 FT
 Datum: WGS84, NAD83, NAD27
 Collection Method:

2 WATER WELL OWNER: City of Manhattan, Ks
 RR#, St. Address, Box #: c/o Middlecreek Corp.
 City, State ZIP Code: 1161 W. 3rd, Peabody, Ks.

GPS unit (Make/Model: _____)
 Digital Map/Photo, Topographic Map, Land Survey
 Est. Accuracy: < 3 m, 3-5 m, 5-15 m, > 15 m

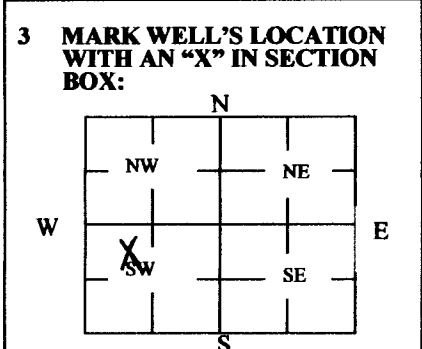

4 DEPTH OF WELL 56 ft. 100' E. OF #1
 WELL'S STATIC WATER LEVEL 17 ft
 WELL WAS USED AS:
 Domestic Public Water Supply Dewatering
 Irrigation Oil Field Water Supply Monitoring
 Feedlot Domestic (Lawn & Garden) Injection Well
 Industrial Air Conditioning Other _____
 Was a chemical/bacteriological sample submitted to Department? Yes No

5 TYPE OF BLANK CASING USED:

Steel RMP (SR) Wrought Fiberglass Other (Specify below)
 PVC ABS Asbestos-Cement Concrete Tile WOOD

Blank casing diameter 8 in. Was casing pulled? Yes No If yes, how much _____
 Casing height above or below land surface 84 in.

6 GROUT PLUG MATERIAL: Neat cement Cement grout Bentonite Other _____
 Grout Plug Intervals: From 7 ft. to 36 ft., From _____ ft. to _____ ft., From _____ to _____ ft.

What is the nearest source of possible contamination:
 Septic tank Seepage pit Fuel Storage Other (specify below)
 Sewer lines Pit privy Fertilizer storage Storm Sewer
 Watertight sewer lines Sewage lagoon Insecticide storage _____
 Lateral lines Feedyard Abandoned water well _____
 Cess pool Livestock pens Oil well/Gas well _____
 Direction from well? south
 How many feet? 80

FROM	TO	PLUGGING MATERIALS	FROM	TO	PLUGGING MATERIALS
0	7	Topsoil			
7	36	Bentonite			
36	56	Gravel			

7 CONTRACTOR'S OR LANDOWNER'S CERTIFICATION: This water well was plugged under my jurisdiction and was completed on (mo/day/year) 3/1/2016 and this record is true to the best of my knowledge and belief. Kansas Water Well Contractor's License No. 138. This Water Well Record was completed on (mo/day/year) 3/3/16 under the business name of Peterson Irrigation, Inc. by (signature) [Signature]

INSTRUCTIONS: Use typewriter or ballpoint pen. Please press firmly and print clearly. Please fill in blanks, underline or circle the correct answers. Send one copy to Kansas Department of Health and Environment, Bureau of Water, Geology Section, 1000 SW Jackson St., Ste. 420, Topeka, Kansas 66612-1367. Telephone: 785/296-5524. Send one to Water Well Owner and retain one for your records. Visit us at <http://www.kdheks.gov/waterwell/index.html>.