

WATER WELL PLUGGING RECORD Form WWC-5P

KSA 82a-1212

ID NO.

NW Well #1


1 LOCATION OF WATER WELL: County: <u>Pottawatomie</u>	Fraction <u>NE 1/4 SW 1/4 NW 1/4 SW 1/4</u>	Section Number <u>17</u>	Township Number <u>T 10 S</u>	Range Number <u>8</u> <input checked="" type="checkbox"/> E <input type="checkbox"/> W
---	--	-----------------------------	----------------------------------	---

Street/Rural Address of Well Location; if unknown, distance & direction from nearest town or intersection: If at owner's address, check here E. of Ft. Riley Blvd & S. of E. Poyntz

in Manhattan, Ks

Global Positioning Systems (GPS) information:
 Latitude: 39.179302 (in decimal degrees)
 Longitude: -96.555229 (in decimal degrees)
 Elevation: 1008 FT
 Datum: WGS84, NAD83, NAD27
 Collection Method:
 GPS unit (Make/Model: _____)
 Digital Map/Photo, Topographic Map, Land Survey
 Est. Accuracy: < 3 m, 3-5 m, 5-15 m, > 15 m

2 WATER WELL OWNER: City of Manhattan, Ks
 RR#, St. Address, Box #: c/o Middlecreek Corp.
 City, State ZIP Code: 1161 W. 3rd, Peabody, Ks.

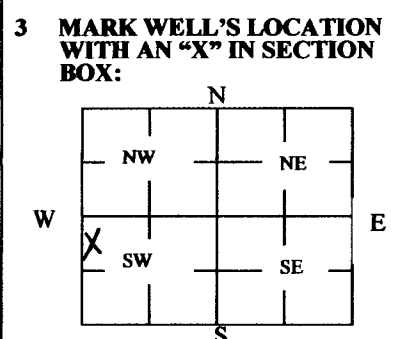

4 DEPTH OF WELL 57 ft.
 WELL'S STATIC WATER LEVEL 17 ft.
 WELL WAS USED AS:
 Domestic Irrigation Feedlot Industrial
 Public Water Supply Oil Field Water Supply Domestic (Lawn & Garden) Air Conditioning
 Dewatering Monitoring Injection Well Other _____
 Was a chemical/bacteriological sample submitted to Department? Yes No

5 TYPE OF BLANK CASING USED:

Steel RMP (SR) Wrought Fiberglass Other (Specify below)
 PVC ABS Asbestos-Cement Concrete Tile WOOD

Blank casing diameter 8 in. Was casing pulled? Yes No If yes, how much _____
 Casing height above or below land surface 84 in.

6 GROUT PLUG MATERIAL: Neat cement Cement grout Bentonite Other _____

Grout Plug Intervals: From 7 ft. to 35 ft., From _____ ft. to _____ ft., From _____ to _____ ft.

What is the nearest source of possible contamination:
 Septic tank Sewer lines Watertight sewer lines Lateral lines Cess pool
 Seepage pit Pit privy Sewage lagoon Feedyard Livestock pens
 Fuel Storage Fertilizer storage Insecticide storage Abandoned water well Oil well/Gas well
 Other (specify below) Storm Sewer
 Direction from well? south
 How many feet? 80

FROM	TO	PLUGGING MATERIALS	FROM	TO	PLUGGING MATERIALS
0	7	Topsoil			
7	35	Bentonite			
35	57	Gravel			

7 CONTRACTOR'S OR LANDOWNER'S CERTIFICATION: This water well was plugged under my jurisdiction and was completed on (mo/day/year) 3/1/2016 and this record is true to the best of my knowledge and belief. Kansas Water Well Contractor's License No. 138. This Water Well Record was completed on (mo/day/year) 3/3/16 under the business name of Peterson Irrigation, Inc. by (signature) Mike Setum

INSTRUCTIONS: Use typewriter or ballpoint pen. Please press firmly and print clearly. Please fill in blanks, underline or circle the correct answers. Send one copy to Kansas Department of Health and Environment, Bureau of Water, Geology Section, 1000 SW Jackson St., Ste. 420, Topeka, Kansas 66612-1367. Telephone: 785/296-5524. Send one to Water Well Owner and retain one for your records. Visit us at <http://www.kdheks.gov/waterwell/index.html>.