

**WATER WELL RECORD Form WWC-5**

Original Record  Correction  Change in Well Use


Division of Water Resources App. No.  

Well ID BSW-09B

<b>1 LOCATION OF WATER WELL:</b> County: Pottawatomie	Fraction ¼ ¼ SE ¼ SE ¼	Section Number 7	Township Number T 10 S	Range Number R 8 <input checked="" type="checkbox"/> E <input type="checkbox"/> W
--	---------------------------	---------------------	---------------------------	--

**2 WELL OWNER:** Last Name:                      First:                       
 Business: **KDHE**  
 Address: **1000 SW Jackson, Suite 110**  
 Address:                       
 City: **Topeka** State: **KS** ZIP: **66612**

Street or Rural Address where well is located (if unknown, distance and direction from nearest town or intersection): If at owner's address, check here:   
**Well is located in basin east of Tuttle Creek Blvd and North of Goodfood Pl. in Manhattan, KS.**

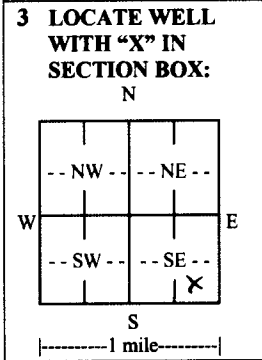

**4 DEPTH OF COMPLETED WELL:** 59.8 ft.  
 Depth(s) Groundwater Encountered: 1) 17 ft.  
 2)                      ft. 3)                      ft., or 4)  Dry Well  
**WELL'S STATIC WATER LEVEL:**                      ft.  
 below land surface, measured on (mo-day-yr)                       
 above land surface, measured on (mo-day-yr)                       
 Pump test data: Well water was                      ft.  
 after                      hours pumping                      gpm  
 Well water was                      ft.  
 after                      hours pumping                      gpm  
 Estimated Yield:                      gpm  
 Bore Hole Diameter: 3.5 in. to 59.8 ft. and  
                     in. to                      ft.

**5 Latitude:** 39.19105 (decimal degrees)  
**Longitude:** 96.55869 (decimal degrees)  
 Horizontal Datum:  WGS 84  NAD 83  NAD 27  
 Source for Latitude/Longitude:  
 GPS (unit make/model: Garmin 60c)  
 (WAAS enabled?  Yes  No)  
 Land Survey  Topographic Map  
 Online Mapper:                     

**6 Elevation:**                      ft.  Ground Level  TOC  
 Source:  Land Survey  GPS  Topographic Map  
 Other                     

**7 WELL WATER TO BE USED AS:**

1. Domestic: <input type="checkbox"/> Household <input type="checkbox"/> Lawn & Garden <input type="checkbox"/> Livestock 2. <input type="checkbox"/> Irrigation 3. <input type="checkbox"/> Feedlot 4. <input type="checkbox"/> Industrial	5. <input type="checkbox"/> Public Water Supply: well ID <u>                    </u> 6. <input type="checkbox"/> Dewatering: how many wells? <u>                    </u> 7. <input type="checkbox"/> Aquifer Recharge: well ID <u>                    </u> 8. <input type="checkbox"/> Monitoring: well ID <u>                    </u> 9. Environmental Remediation: well ID <u>BSW-09B</u> <input checked="" type="checkbox"/> Air Sparge <input type="checkbox"/> Soil Vapor Extraction <input type="checkbox"/> Recovery <input type="checkbox"/> Injection	10. <input type="checkbox"/> Oil Field Water Supply: lease <u>                    </u> 11. Test Hole: well ID <u>                    </u> <input type="checkbox"/> Cased <input type="checkbox"/> Uncased <input type="checkbox"/> Geotechnical 12. Geothermal: how many bores? <u>                    </u> a) Closed Loop <input type="checkbox"/> Horizontal <input type="checkbox"/> Vertical b) Open Loop <input type="checkbox"/> Surface Discharge <input type="checkbox"/> Inj. of Water 13. <input type="checkbox"/> Other (specify): <u>                    </u>
---	--	---

**Was a chemical/bacteriological sample submitted to KDHE?**  Yes  No If yes, date sample was submitted:                       
 Water well disinfected?  Yes  No

**8 TYPE OF CASING USED:**  Steel  PVC  Other                      CASING JOINTS:  Glued  Clamped  Welded  Threaded  
 Casing diameter 1 in. to 58.8 ft., Diameter                      in. to                      ft., Diameter                      in. to                      ft.  
 Casing height above land surface -0.3 in. Weight                      lbs./ft. Wall thickness or gauge No. Sch. 80  
**TYPE OF SCREEN OR PERFORATION MATERIAL:**  
 Steel  Stainless Steel  Fiberglass  PVC  Other (Specify)                       
 Brass  Galvanized Steel  Concrete tile  None used (open hole)  
**SCREEN OR PERFORATION OPENINGS ARE:**  
 Continuous Slot  Mill Slot  Gauze Wrapped  Torch Cut  Drilled Holes  Other (Specify)                       
 Louvered Shutter  Key Punched  Wire Wrapped  Saw Cut  None (Open Hole)  
**SCREEN-PERFORATED INTERVALS:** From 59.8 ft. to 58.8 ft., From                      ft. to                      ft., From                      ft. to                      ft.  
**GRAVEL PACK INTERVALS:** From 60 ft. to 57.9 ft., From                      ft. to                      ft., From                      ft. to                      ft.

**9 GROUT MATERIAL:**  Neat cement  Cement grout  Bentonite  Other                       
 Grout Intervals: From 57.9 ft. to 54.6 ft., From 54.6 ft. to 2 ft., From                      ft. to                      ft.  
**Nearest source of possible contamination:**  
 Septic Tank  Lateral Lines  Pit Privy  Livestock Pens  Insecticide Storage  
 Sewer Lines  Cess Pool  Sewage Lagoon  Fuel Storage  Abandoned Water Well  
 Watertight Sewer Lines  Seepage Pit  Feedyard  Fertilizer Storage  Oil Well/Gas Well  
 Other (Specify) Dry Cleaner Facility  
 Direction from well?                      Distance from well?                      ft.

10 FROM	TO	LITHOLOGIC LOG	FROM	TO	LITHO. LOG (cont.) or PLUGGING INTERVALS
0	3	Topsoil			
3	17	Clay, Tan, Stiff			
17	60	Sand, fine grain, poorly sorted, becoming larger grain as depth increases.			

**Notes:** Cinderella/Stickel Cleaners Project

**11 CONTRACTOR'S OR LANDOWNER'S CERTIFICATION:** This water well was  constructed,  reconstructed, or  plugged under my jurisdiction and was completed on (mo-day-year) 10/25/2017 and this record is true to the best of my knowledge and belief. Kansas Water Well Contractor's License No. 710 This Water Well Record was completed on (mo-day-year) 11/13/2017 under the business name of Below Ground Surface, Inc.