


Path: Z:\Clients\ENSO\OneGas\103248_Manhattan\2017\Studies\Geospatial\DataFiles\ArcDocs\1-3SI_Monitoring_Well_&_SGP_Locations\2018.mxd kdbaker 6/29/2018
COPYRIGHT © 2018 BURNS & MCDONNELL ENGINEERING COMPANY, INC.
Service Layer Credits: Esri, HERE, Garmin, © OpenStreetMap contributors, and the GIS user community
Source: Esri, DigitalGlobe, GeoEye, Earthstar Geographics, CNES/Airbus DS, USDA, USGS, AeroGRID, IGN, and the GIS User Community

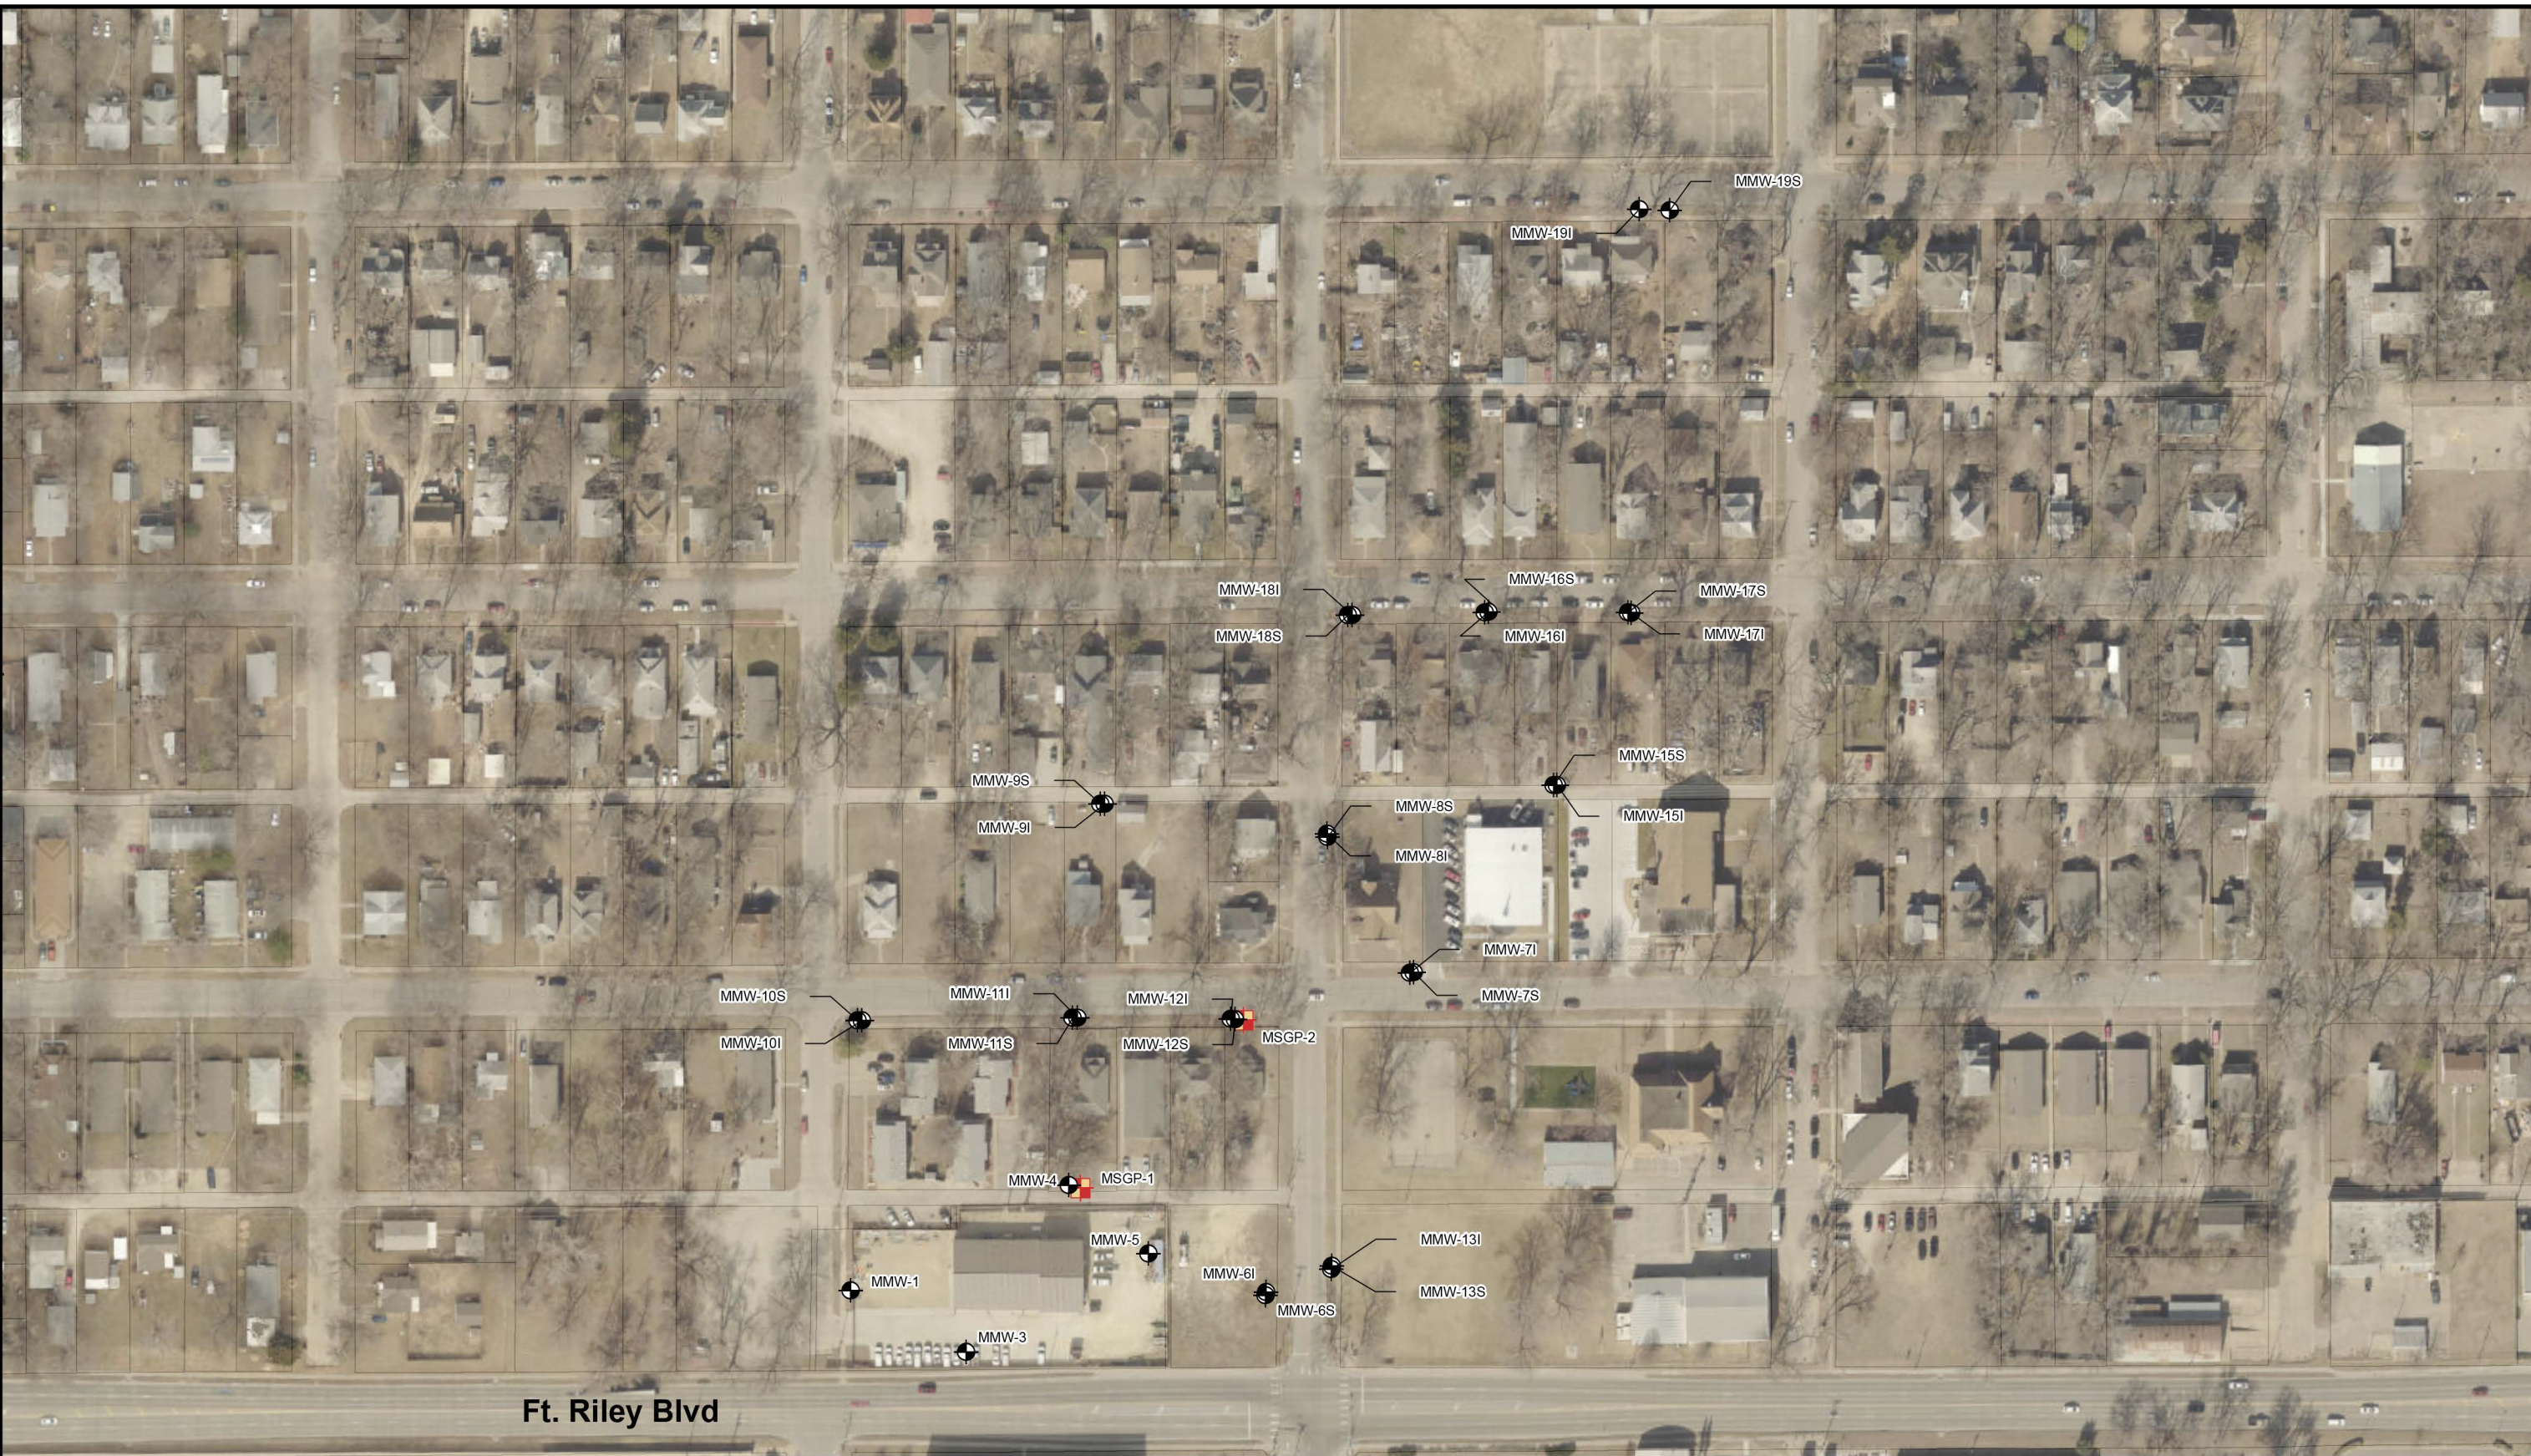

Ft. Riley Blvd

Legend

- Monitoring Well
- Soil Gas Probe
- Parcel Boundary

NORTH

0 100 200
Scale in Feet



Figure 1-3
SI Monitoring Well &
Soil Gas Probe
Locations
ONE GAS, INC.
MANHATTAN, KANSAS