


**WATER WELL RECORD      Form WWC-5**☐ Original Record    ☐ Correction    ☐ Change in Well Use

Division of Water  
Resources App. No.

Well ID


[illegible]



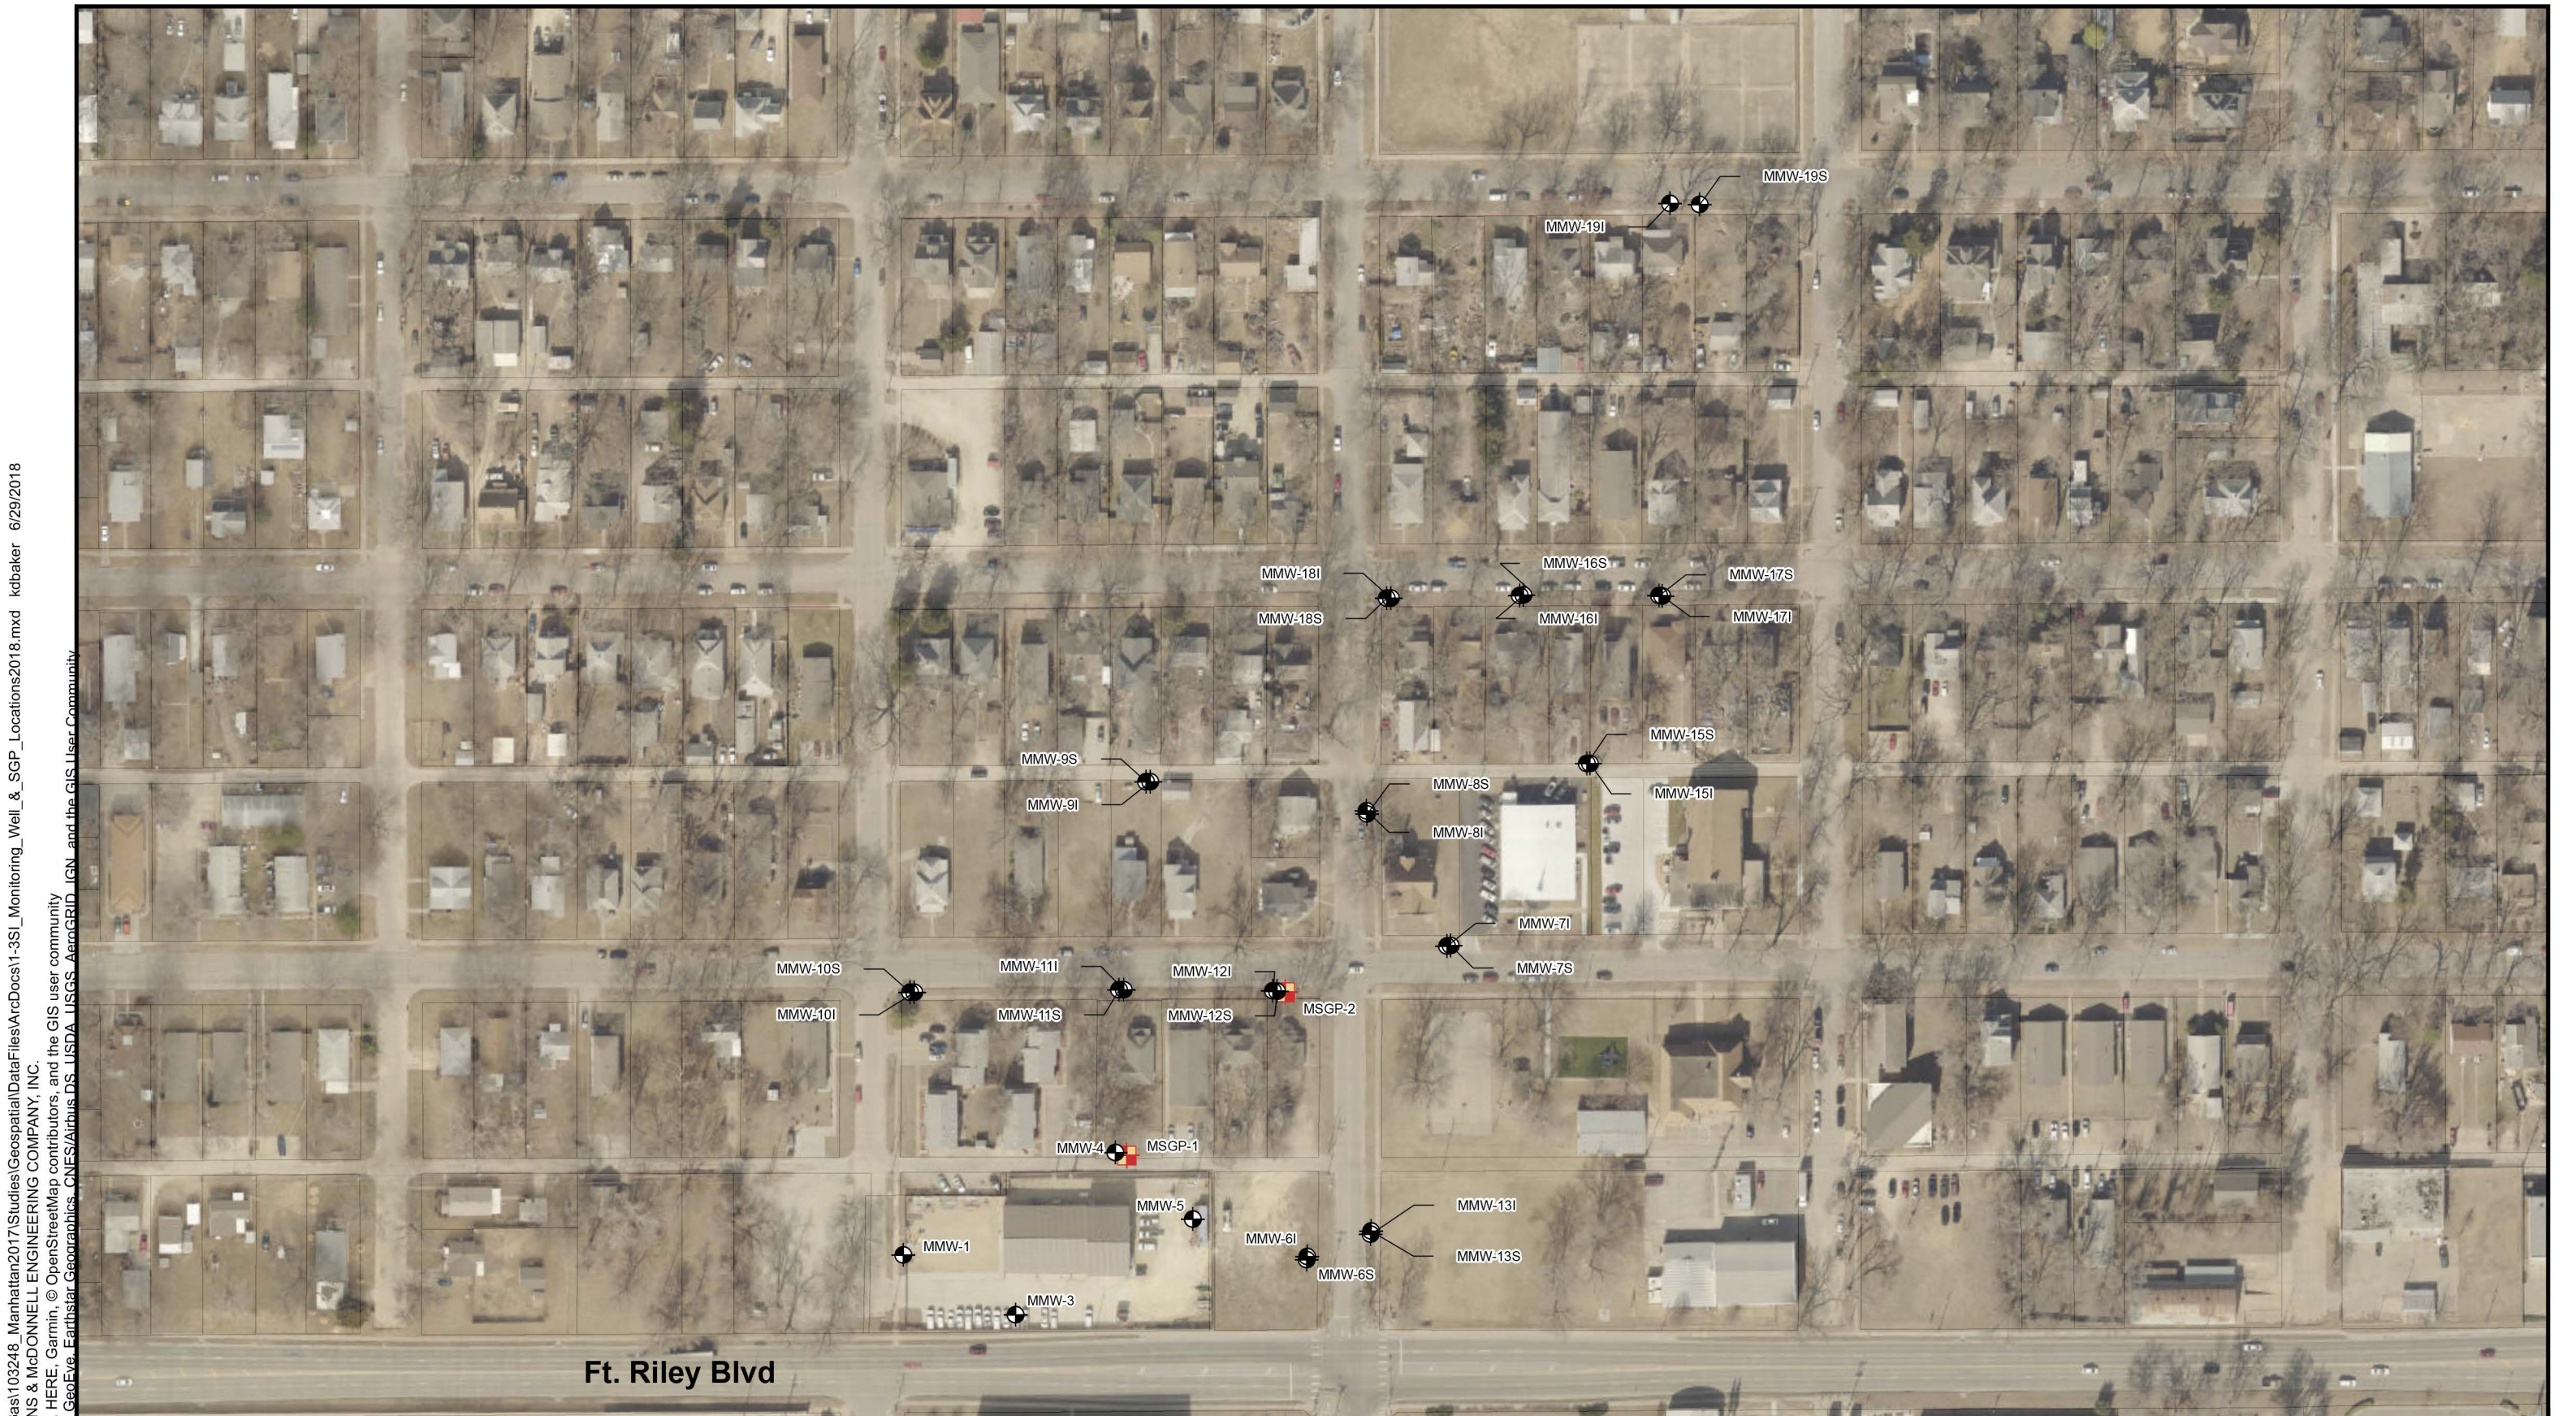

**Legend**

- Monitoring Well
- Soil Gas Probe
- Parcel Boundary

 NORTH

0 100 200  
Scale in Feet



Figure 1-3  
SI Monitoring Well &  
Soil Gas Probe  
Locations  
ONE GAS, INC.  
MANHATTAN, KANSAS

Path: Z:\Clients\ENSO\OneGas\103248\_Manhattan\2017\Studies\Geospatial\DataFiles\ArcDocs\1-3SI\_Monitoring\_Well\_&\_SGP\_Locations\2018.mxd kdbaker 6/29/2018  
COPYRIGHT © 2018 BURNS & McDONNELL ENGINEERING COMPANY, INC.  
Service Layer Credits: Esri, HERE, Garmin, © OpenStreetMap contributors, and the GIS user community  
Source: Esri, DigitalGlobe, GeoEye, Earthstar Geographics, CNES/Airbus DS, USDA, USGS, AeroGRID, IGN, and the GIS User Community