

MMW-7S


☒ Original Record ☐ Correction ☐ Change in Well Use

Well ID

1 LOCATION OF WATER WELL: County: <u>Riley</u>		Fraction: <u>SE 1/4 SW 1/4 SW 1/4 SE 1/4</u>		Section Number: <u>18</u>																
				Township Number: <u>T 10 S</u>																
				Range Number: <u>R 8 E W</u>																
2 WELL OWNER: Last Name: _____ First: _____ Business: <u>ONE Gas, Inc.</u> Address: <u>15 East Fifth Street</u> City: <u>Tulsa</u> State: <u>OK</u> ZIP: <u>74103</u>				Street or Rural Address where well is located (if unknown, distance and direction from nearest town or intersection): If at owner's address, check here: <input type="checkbox"/> <u>515 S. 11th Street, Manhattan</u>																
3 LOCATE WELL WITH "X" IN SECTION BOX: <div style="text-align: center;"> </div>		4 DEPTH OF COMPLETED WELL: <u>29</u> ft. Depth(s) Groundwater Encountered: 1) ft. 2) ft. 3) ft., or 4) <input type="checkbox"/> Dry Well WELL'S STATIC WATER LEVEL: ft. <input type="checkbox"/> below land surface, measured on (mo-day-yr)..... <input type="checkbox"/> above land surface, measured on (mo-day-yr)..... Pump test data: Well water was ft. after hours pumping gpm Well water was ft. after hours pumping gpm Estimated Yield: gpm Bore Hole Diameter: <u>8</u> in. to <u>29</u> ft. and in. to ft.		5 Latitude: <u>39.175307</u> (decimal degrees) Longitude: <u>-96.571508</u> (decimal degrees) Horizontal Datum: <input type="checkbox"/> WGS 84 <input checked="" type="checkbox"/> NAD 83 <input type="checkbox"/> NAD 27 Source for Latitude/Longitude: <input type="checkbox"/> GPS (unit make/model:) (WAAS enabled? <input type="checkbox"/> Yes <input type="checkbox"/> No) <input checked="" type="checkbox"/> Land Survey <input type="checkbox"/> Topographic Map <input type="checkbox"/> Online Mapper:																
7 WELL WATER TO BE USED AS: 1. Domestic: <input type="checkbox"/> Household <input type="checkbox"/> Lawn & Garden <input type="checkbox"/> Livestock <input type="checkbox"/> Irrigation 2. <input type="checkbox"/> Feedlot 3. <input type="checkbox"/> Industrial 4. <input type="checkbox"/> Public Water Supply: well ID 5. <input type="checkbox"/> Dewatering: how many wells? 6. <input type="checkbox"/> Aquifer Recharge: well ID 7. <input checked="" type="checkbox"/> Monitoring: well ID <u>MMW-7S</u> 8. Environmental Remediation: well ID <input type="checkbox"/> Air Sparge <input type="checkbox"/> Soil Vapor Extraction <input type="checkbox"/> Recovery <input type="checkbox"/> Injection 9. <input type="checkbox"/> Oil Field Water Supply: lease 10. <input type="checkbox"/> Test Hole: well ID <input type="checkbox"/> Cased <input type="checkbox"/> Uncased <input type="checkbox"/> Geotechnical 11. Geothermal: how many bores? a) Closed Loop <input type="checkbox"/> Horizontal <input type="checkbox"/> Vertical b) Open Loop <input type="checkbox"/> Surface Discharge <input type="checkbox"/> Inj. of Water 12. <input type="checkbox"/> Other (specify):		6 Elevation: <u>1019.84</u> ft. <input checked="" type="checkbox"/> Ground Level <input type="checkbox"/> TOC Source: <input checked="" type="checkbox"/> Land Survey <input type="checkbox"/> GPS <input type="checkbox"/> Topographic Map <input type="checkbox"/> Other																		
Was a chemical/bacteriological sample submitted to KDHE? <input type="checkbox"/> Yes <input checked="" type="checkbox"/> No If yes, date sample was submitted: Water well disinfected? <input type="checkbox"/> Yes <input checked="" type="checkbox"/> No																				
8 TYPE OF CASING USED: <input type="checkbox"/> Steel <input checked="" type="checkbox"/> PVC <input type="checkbox"/> Other CASING JOINTS: <input type="checkbox"/> Glued <input type="checkbox"/> Clamped <input type="checkbox"/> Welded <input checked="" type="checkbox"/> Threaded Casing diameter <u>2</u> in. to <u>19</u> ft., Diameter in. to ft., Diameter in. to ft. Casing height above land surface <u>0</u> in. Weight lbs./ft. Wall thickness or gauge No. <u>Sch. 40</u> TYPE OF SCREEN OR PERFORATION MATERIAL: <input type="checkbox"/> Steel <input type="checkbox"/> Stainless Steel <input type="checkbox"/> Fiberglass <input checked="" type="checkbox"/> PVC <input type="checkbox"/> Other (Specify) <input type="checkbox"/> Brass <input type="checkbox"/> Galvanized Steel <input type="checkbox"/> Concrete tile <input type="checkbox"/> None used (open hole).																				
SCREEN OR PERFORATION OPENINGS ARE: <input type="checkbox"/> Continuous Slot <input checked="" type="checkbox"/> Mill Slot <input type="checkbox"/> Gauze Wrapped <input type="checkbox"/> Torch Cut <input type="checkbox"/> Drilled Holes <input type="checkbox"/> Other (Specify) <input type="checkbox"/> Louvered Shutter <input type="checkbox"/> Key Punched <input type="checkbox"/> Wire Wrapped <input type="checkbox"/> Saw Cut <input type="checkbox"/> None (Open Hole)																				
SCREEN-PERFORATED INTERVALS: From <u>19</u> ft. to <u>29</u> ft., From ft. to ft., From ft. to ft. GRAVEL PACK INTERVALS: From <u>14.5</u> ft. to <u>29</u> ft., From ft. to ft., From ft. to ft.																				
GROUT MATERIAL: <input type="checkbox"/> Neat cement <input type="checkbox"/> Cement grout <input checked="" type="checkbox"/> Bentonite <input checked="" type="checkbox"/> Other <u>Concrete</u> Grout Intervals: From <u>0</u> ft. to <u>3</u> ft., From <u>3</u> ft. to <u>14.5</u> ft., From ft. to ft.																				
Nearest source of possible contamination: <input type="checkbox"/> Septic Tank <input type="checkbox"/> Lateral Lines <input type="checkbox"/> Pit Privy <input type="checkbox"/> Livestock Pens <input type="checkbox"/> Insecticide Storage <input type="checkbox"/> Sewer Lines <input type="checkbox"/> Cess Pool <input type="checkbox"/> Sewage Lagoon <input type="checkbox"/> Fuel Storage <input type="checkbox"/> Abandoned Water Well <input type="checkbox"/> Watertight Sewer Lines <input type="checkbox"/> Seepage Pit <input type="checkbox"/> Feedyard <input type="checkbox"/> Fertilizer Storage <input type="checkbox"/> Oil Well/Gas Well <input checked="" type="checkbox"/> Other (Specify) <u>former manufactured gas site</u> Direction from well? Distance from well? ft.																				
LITHOLOGIC LOG <table border="1" style="width: 100%; border-collapse: collapse;"> <thead> <tr> <th>FROM</th> <th>TO</th> <th>LITHO. LOG (cont.) or PLUGGING INTERVALS</th> </tr> </thead> <tbody> <tr> <td>11.5</td> <td>15</td> <td>Sand, f, some silt</td> </tr> <tr> <td>15</td> <td>20</td> <td>Clay, some silt</td> </tr> <tr> <td>20</td> <td>29</td> <td>Silt, some clay, tr. sand</td> </tr> <tr> <td>29</td> <td></td> <td>Sand, f, tr. silt</td> </tr> </tbody> </table>			FROM	TO	LITHO. LOG (cont.) or PLUGGING INTERVALS	11.5	15	Sand, f, some silt	15	20	Clay, some silt	20	29	Silt, some clay, tr. sand	29		Sand, f, tr. silt	Notes: 		
FROM	TO	LITHO. LOG (cont.) or PLUGGING INTERVALS																		
11.5	15	Sand, f, some silt																		
15	20	Clay, some silt																		
20	29	Silt, some clay, tr. sand																		
29		Sand, f, tr. silt																		
CONTRACTOR'S OR LANDOWNER'S CERTIFICATION: This water well was <input checked="" type="checkbox"/> constructed, <input type="checkbox"/> reconstructed, or <input type="checkbox"/> plugged under my jurisdiction and was completed on (mo-day-year) <u>7/27/2017</u> and this record is true to the best of my knowledge and belief. Kansas Water Well Contractor's License No. <u>527</u> This Water Well Record was completed on (mo-day-year) <u>8/25/2017</u> Under the business name of <u>GeoCore Inc.</u> Signature: <u>[Signature]</u> Mail 1 white copy along with a fee of \$5.00 for each constructed well to: Kansas Department of Health and Environment, Bureau of Water, GWTS Section, 1000 SW Jackson St., Suite 420, Topeka, Kansas 66612-1367. Mail one to Water Well Owner and retain one for your records. Telephone 785-296-5524. Visit us at http://www.kdheks.gov/waterwell/index.html KSA 82a-1212 Revised 7/10/2015																				

Riley

18-10-8E

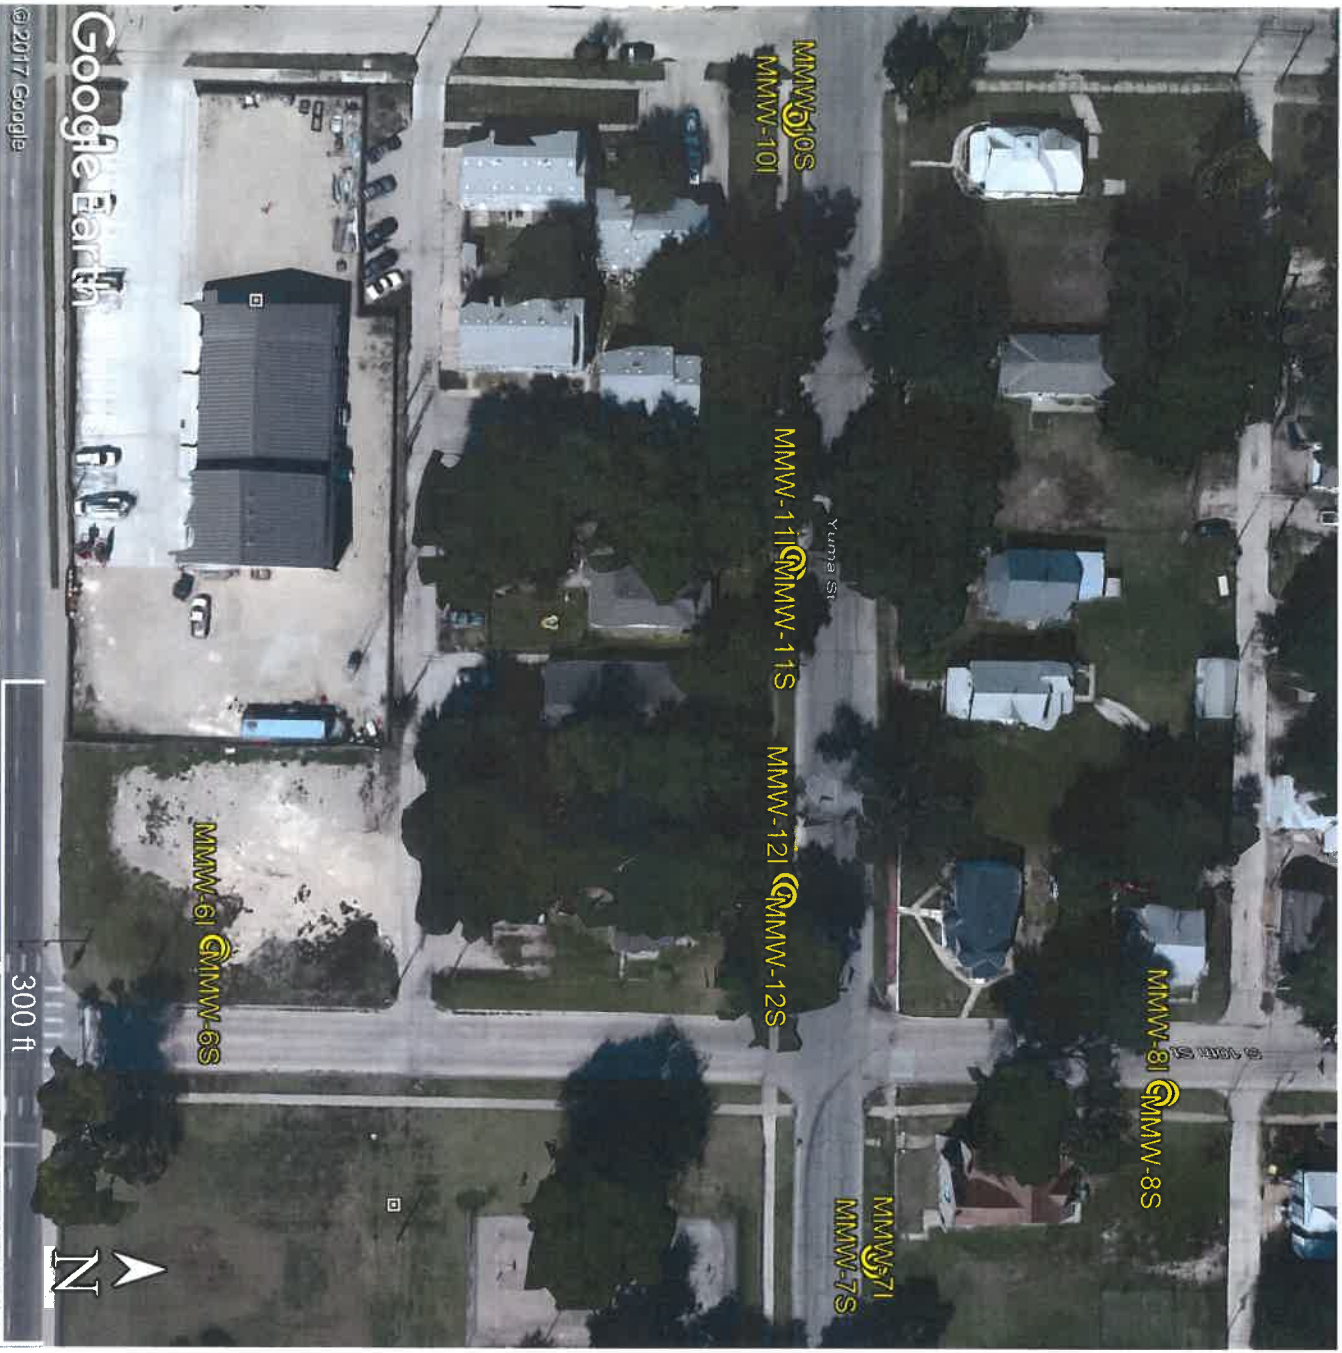

ONE Gas – Manhattan MGP Site (for Burns and McDonell)
515 S. 11th Street, Manhattan, Kansas

GPS Coordinates:

MMW-6I: 39.1744943, -96.5719465
MMW-7I: 39.1753152, -96.5714534
MMW-8I: 39.1756761, -96.5717184
MMW-10I: 39.1752158, -96.5732630
MMW-11I: 39.1752132, -96.5725527
MMW-12I: 39.1752053, -96.5720468

MMW-6S: 39.1745002, -96.5719436
MMW-7S: 39.1753162, -96.5714398
MMW-8S: 39.1756676, -96.5717183
MMW-10S: 39.1752155, -96.5732778
MMW-11S: 39.1752134, -96.5725679
MMW-12S: 39.1752030, -96.5720320

RECEIVED

OCT 16 2017

BUREAU OF WATER