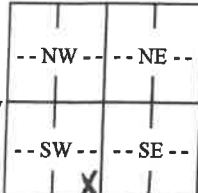


☒ Original Record ☐ Correction ☐ Change in Well Use

Well ID

MMW-101

| | | | | | |
|---|---|--|---|----------------------------------|--------------------------------|
| 1 LOCATION OF WATER WELL: County: Riley | | Fraction SW ¼ SE ¼ SE ¼ SW ¼ | Section Number 18 | Township Number T 10 S | Range Number R 8 E W |
| 2 WELL OWNER: Last Name: _____ First: _____ Business: ONE Gas, Inc. Address: 15 East Fifth Street City: Tulsa State: OK ZIP: 74103 | | | Street or Rural Address where well is located (if unknown, distance and direction from nearest town or intersection): If at owner's address, check here: <input type="checkbox"/> 515 S. 11th Street, Manhattan | | |
| 3 LOCATE WELL WITH "X" IN SECTION BOX: <div style="text-align: center;">N</div>  <div style="text-align: center;">S</div> <div style="text-align: center;">W ————— 1 mile ————— E</div> | 4 DEPTH OF COMPLETED WELL: 50 ft. Depth(s) Groundwater Encountered: 1) ft. 2) ft. 3) ft., or 4) <input type="checkbox"/> Dry Well WELL'S STATIC WATER LEVEL: ft. <input type="checkbox"/> below land surface, measured on (mo-day-yr)..... <input type="checkbox"/> above land surface, measured on (mo-day-yr)..... Pump test data: Well water was ft. after..... hours pumping gpm Well water was ft. after..... hours pumping gpm Estimated Yield: gpm Bore Hole Diameter: 8 in. to 50 ft. and in. to ft. | | 5 Latitude: 39.1752158 (decimal degrees) Longitude: -96.5732630 (decimal degrees) <u>Horizontal Datum:</u> <input type="checkbox"/> WGS 84 <input checked="" type="checkbox"/> NAD 83 <input type="checkbox"/> NAD 27 <u>Source for Latitude/Longitude:</u> <input type="checkbox"/> GPS (unit make/model:) (WAAS enabled? Yes No) <input checked="" type="checkbox"/> Land Survey <input type="checkbox"/> Topographic Map <input type="checkbox"/> Online Mapper: | | |
| | | 6 Elevation: 1018.70 ft. <input checked="" type="checkbox"/> Ground Level <input type="checkbox"/> TOC <u>Source:</u> <input checked="" type="checkbox"/> Land Survey <input type="checkbox"/> GPS <input type="checkbox"/> Topographic Map <input type="checkbox"/> Other | | | |

7 WELL WATER TO BE USED AS:

| | | |
|--|---|---|
| 1. Domestic: <input type="checkbox"/> Household <input type="checkbox"/> Lawn & Garden <input type="checkbox"/> Livestock | 5. <input type="checkbox"/> Public Water Supply: well ID | 10. <input type="checkbox"/> Oil Field Water Supply: lease |
| 2. <input type="checkbox"/> Irrigation | 6. <input type="checkbox"/> Dewatering: how many wells? | 11. Test Hole: well ID <input type="checkbox"/> Cased <input type="checkbox"/> Uncased <input type="checkbox"/> Geotechnical |
| 3. <input type="checkbox"/> Feedlot | 7. <input type="checkbox"/> Aquifer Recharge: well ID | 12. Geothermal: how many bores? a) Closed Loop <input type="checkbox"/> Horizontal <input type="checkbox"/> Vertical |
| 4. <input type="checkbox"/> Industrial | 8. <input checked="" type="checkbox"/> Monitoring: well ID MMW-101 | b) Open Loop <input type="checkbox"/> Surface Discharge <input type="checkbox"/> Inj. of Water |
| | 9. Environmental Remediation: well ID <input type="checkbox"/> Air Sparge <input type="checkbox"/> Soil Vapor Extraction <input type="checkbox"/> Recovery <input type="checkbox"/> Injection | 13. <input type="checkbox"/> Other (specify): |

Was a chemical/bacteriological sample submitted to KDHE? ☐ Yes ☒ No If yes, date sample was submitted:

Water well disinfected? ☐ Yes ☒ No

8 TYPE OF CASING USED: ☐ Steel ☒ PVC ☐ Other CASING JOINTS: ☐ Glued ☐ Clamped ☐ Welded ☒ Threaded
Casing diameter 2 in. to 40 ft., Diameter in. to ft., Diameter in. to ft.
Casing height above land surface in. Weight lbs./ft. Wall thickness or gauge No. Sch. 40

TYPE OF SCREEN OR PERFORATION MATERIAL:

| | | | | |
|--------------------------------|---|--|--|--|
| <input type="checkbox"/> Steel | <input type="checkbox"/> Stainless Steel | <input type="checkbox"/> Fiberglass | <input checked="" type="checkbox"/> PVC | <input type="checkbox"/> Other (Specify) |
| <input type="checkbox"/> Brass | <input type="checkbox"/> Galvanized Steel | <input type="checkbox"/> Concrete tile | <input type="checkbox"/> None used (open hole) | |

SCREEN OR PERFORATION OPENINGS ARE:

| | | | | | |
|---|---|--|------------------------------------|---|--|
| <input type="checkbox"/> Continuous Slot | <input checked="" type="checkbox"/> Mill Slot | <input type="checkbox"/> Gauze Wrapped | <input type="checkbox"/> Torch Cut | <input type="checkbox"/> Drilled Holes | <input type="checkbox"/> Other (Specify) |
| <input type="checkbox"/> Louvered Shutter | <input type="checkbox"/> Key Punched | <input type="checkbox"/> Wire Wrapped | <input type="checkbox"/> Saw Cut | <input type="checkbox"/> None (Open Hole) | |

SCREEN-PERFORATED INTERVALS: From 40 ft. to 50 ft., From ft. to ft., From ft. to ft.
GRAVEL PACK INTERVALS: From 35 ft. to 50 ft., From ft. to ft., From ft. to ft.

9 GROUT MATERIAL: ☐ Neat cement ☐ Cement grout ☒ Bentonite ☒ Other Concrete
Grout Intervals: From 0 ft. to 3 ft., From 3 ft. to 35 ft., From _____ ft. to _____ ft.

Nearest source of possible contamination:

| | | | | |
|---|--|--|---|---|
| <input type="checkbox"/> Septic Tank | <input type="checkbox"/> Lateral Lines | <input type="checkbox"/> Pit Privy | <input type="checkbox"/> Livestock Pens | <input type="checkbox"/> Insecticide Storage |
| <input type="checkbox"/> Sewer Lines | <input type="checkbox"/> Cess Pool | <input type="checkbox"/> Sewage Lagoon | <input type="checkbox"/> Fuel Storage | <input type="checkbox"/> Abandoned Water Well |
| <input type="checkbox"/> Watertight Sewer Lines | <input type="checkbox"/> Seepage Pit | <input type="checkbox"/> Feedyard | <input type="checkbox"/> Fertilizer Storage | <input type="checkbox"/> Oil Well/Gas Well |

☐ Other (Specify) former manufactured gas site
 Direction from well? Distance from well? ft

[illegible]

11 CONTRACTOR'S OR LANDOWNER'S CERTIFICATION: This water well was ☒ constructed, ☐ reconstructed, or ☐ plugged under my jurisdiction and was completed on (mo-day-year) 7/27/2017..... and this record is true to the best of my knowledge and belief. Kansas Water Well Contractor's License No. 527..... This Water Well Record was completed on (mo-day-year) 8/25/2017..... under the business name of GeoCore Inc...... Signature Joe Bell


Mail 1 white copy along with a fee of \$5.00 for each constructed well to: Kansas Department of Health and Environment, Bureau of Water, GWTS Section, 1000 SW Jackson St., Suite 420, Topeka, Kansas 66612-1367. Mail one to Water Well Owner and retain one for your records. Telephone 785-296-5524.

KSA 82a-1212

Revised 7/10/2015

Riley

18-10-8E

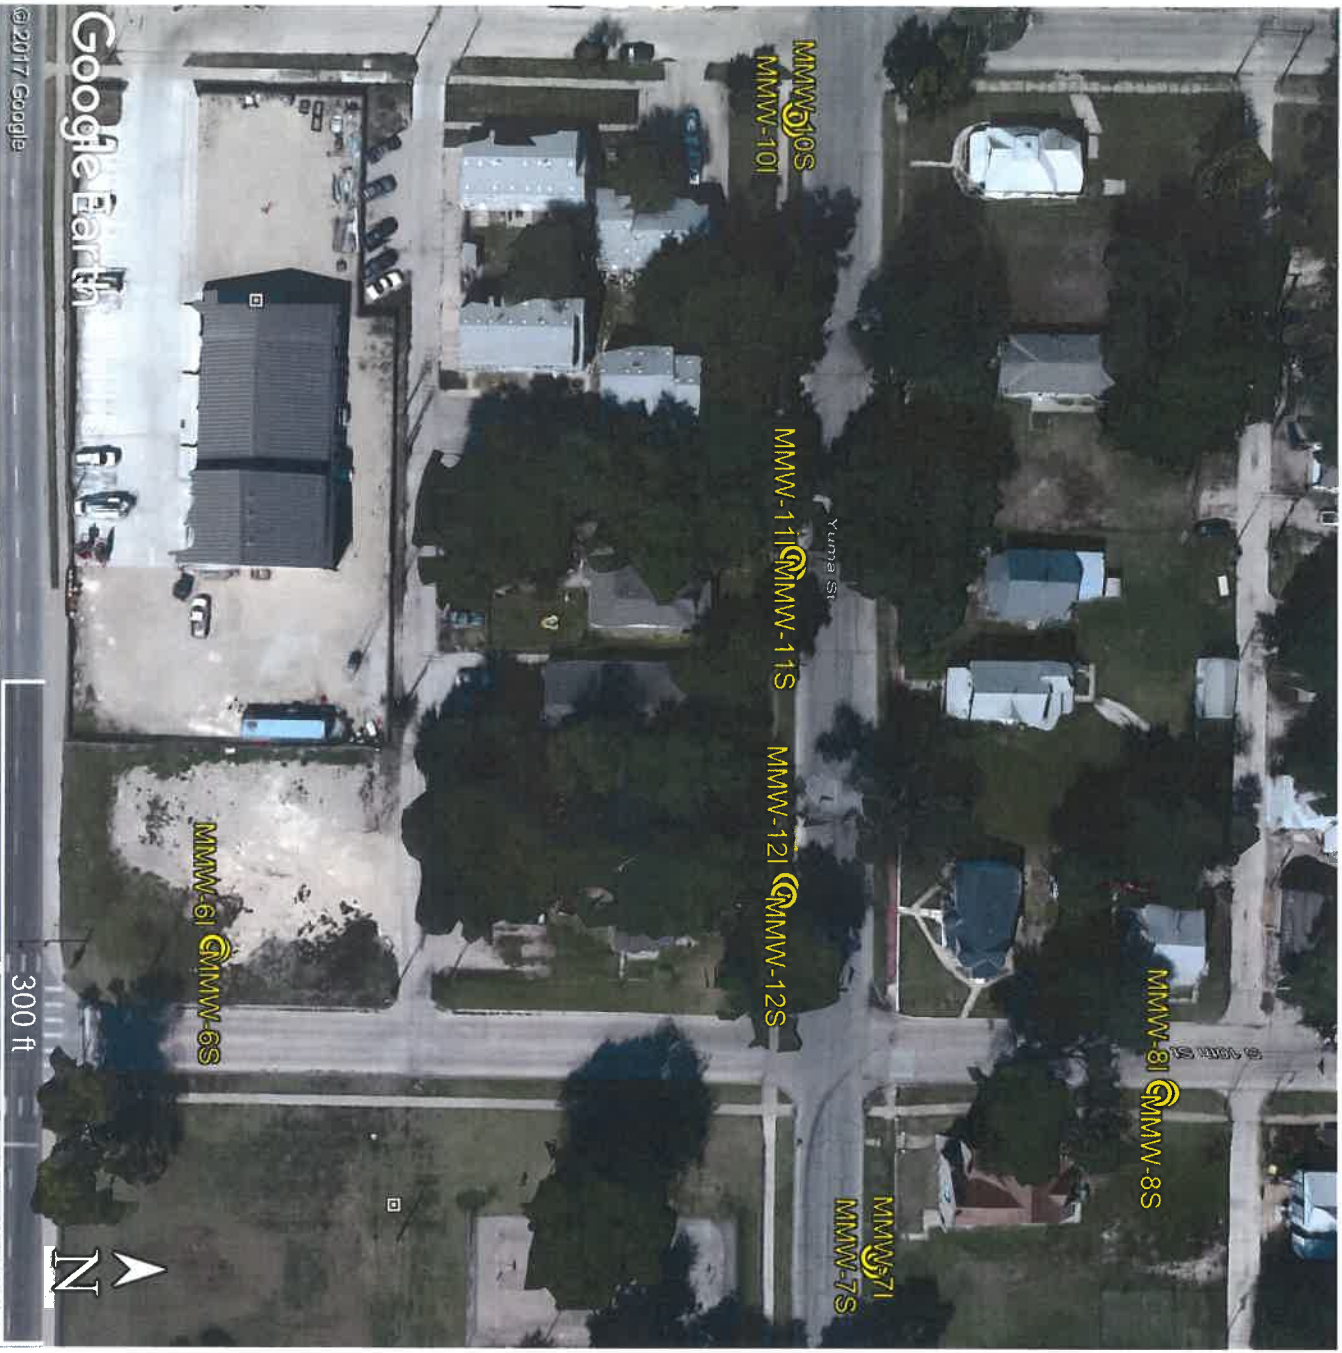

ONE Gas – Manhattan MGP Site (for Burns and McDonell)
515 S. 11th Street, Manhattan, Kansas

GPS Coordinates:

MMW-6I: 39.1744943, -96.5719465
MMW-7I: 39.1753152, -96.5714534
MMW-8I: 39.1756761, -96.5717184
MMW-10I: 39.1752158, -96.5732630
MMW-11I: 39.1752132, -96.5725527
MMW-12I: 39.1752053, -96.5720468

MMW-6S: 39.1745002, -96.5719436
MMW-7S: 39.1753162, -96.5714398
MMW-8S: 39.1756676, -96.5717183
MMW-10S: 39.1752155, -96.5732778
MMW-11S: 39.1752134, -96.5725679
MMW-12S: 39.1752030, -96.5720320

RECEIVED

OCT 16 2017

BUREAU OF WATER