

**WATER WELL PLUGGING RECORD Form WWC-5P**

KSA 82a-1212 ID NO.

4


**1 LOCATION OF WATER WELL:** Fraction NE 1/4 NE 1/4 SW 1/4 NW 1/4 Section Number 18 Township Number T 10 S Range Number 8  E  W  
 County: Riley

Street/Rural Address of Well Location; if unknown, distance & direction from nearest town or intersection: If at owner's address, check here  Former Amoco Gas Station #8819  
 1701 Anderson Ave.  
 Manhattan, KS

**Global Positioning Systems (GPS) information:**  
 Latitude: 38.185923 (in decimal degrees)  
 Longitude: -96.583781 (in decimal degrees)  
 Elevation:  
 Horizontal Datum:  WGS84,  NAD83,  NAD27  
 Collection Method:

**2 WATER WELL OWNER:** Atlantic Richfield Company  
 RR#, St. Address, Box #: 501 Westlake Park Blvd.  
 City, State ZIP Code: Houston TX 77079

GPS unit (Make/Model: garim etrek)  
 Digital Map/Photo,  Topographic Map,  Land Survey  
 Est. Accuracy:  < 3 m,  3-5 m,  5-15 m,  > 15 m

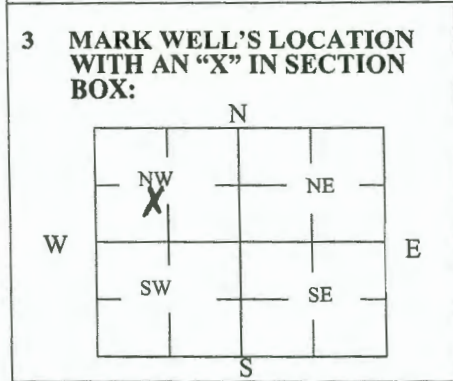

**4 DEPTH OF WELL** 25 ft.  
 WELL'S STATIC WATER LEVEL 14.3 ft.  
 WELL WAS USED AS:  
 Domestic  Public Water Supply  Dewatering  
 Irrigation  Oil Field Water Supply  Monitoring  
 Feedlot  Domestic (Lawn & Garden)  Injection Well  
 Industrial  Air Conditioning  Other \_\_\_\_\_  
 Was a chemical/bacteriological sample submitted to Department? Yes  No

**5 TYPE OF BLANK CASING USED:**

Steel  RMP (SR)  Wrought  Fiberglass  Other (Specify below) \_\_\_\_\_  
 PVC  ABS  Asbestos-Cement  Concrete Tile

Blank casing diameter 2 in. Was casing pulled? Yes  No  If yes, how much all  
 Casing height above or below land surface -6 in.

**6 GROUT PLUG MATERIAL:**  Neat cement  Cement grout  Bentonite  Other Top Soil

Grout Plug Intervals: From 0 ft. to 3 ft., From 3 ft. to 25 ft., From - ft. to - ft.


What is the nearest source of possible contamination:  
 Septic tank  Seepage pit  Fuel storage  Other (specify below) \_\_\_\_\_  
 Sewer lines  Pit privy  Fertilizer storage  
 Watertight sewer lines  Sewage lagoon  Insecticide storage  
 Lateral lines  Feedyard  Abandoned water well Direction from well? Southeast  
 Cess pool  Livestock pens  Oil well/Gas well How many feet? 10

FROM	TO	PLUGGING MATERIALS	FROM	TO	PLUGGING MATERIALS
0	3	<u>Top Soil</u>			
3	<u>25</u>	Bentonite			

**7 CONTRACTOR'S OR LANDOWNER'S CERTIFICATION:** This water well was plugged under my jurisdiction and was completed on (mo/day/year) 2-4-2019 and this record is true to the best of my knowledge and belief. Kansas Water Well Contractor's License No. 710. This Water Well Record was completed on (mo/day/year) 2-18-19 under the business name of Below Ground Surface, Inc. by (signature) Craig K. Hewitt

Send one white copy to Kansas Department of Health & Environment, Geology Section, 1000 SW Jackson Street, Ste. 420, Topeka, KS 66612-1367. Send one copy to WATER WELL OWNER and retain one for your records.  
 Visit us at <http://www.kdheks.gov/waterwell/index.html> Telephone 785-296-5524.

ANDERSON AVENUE

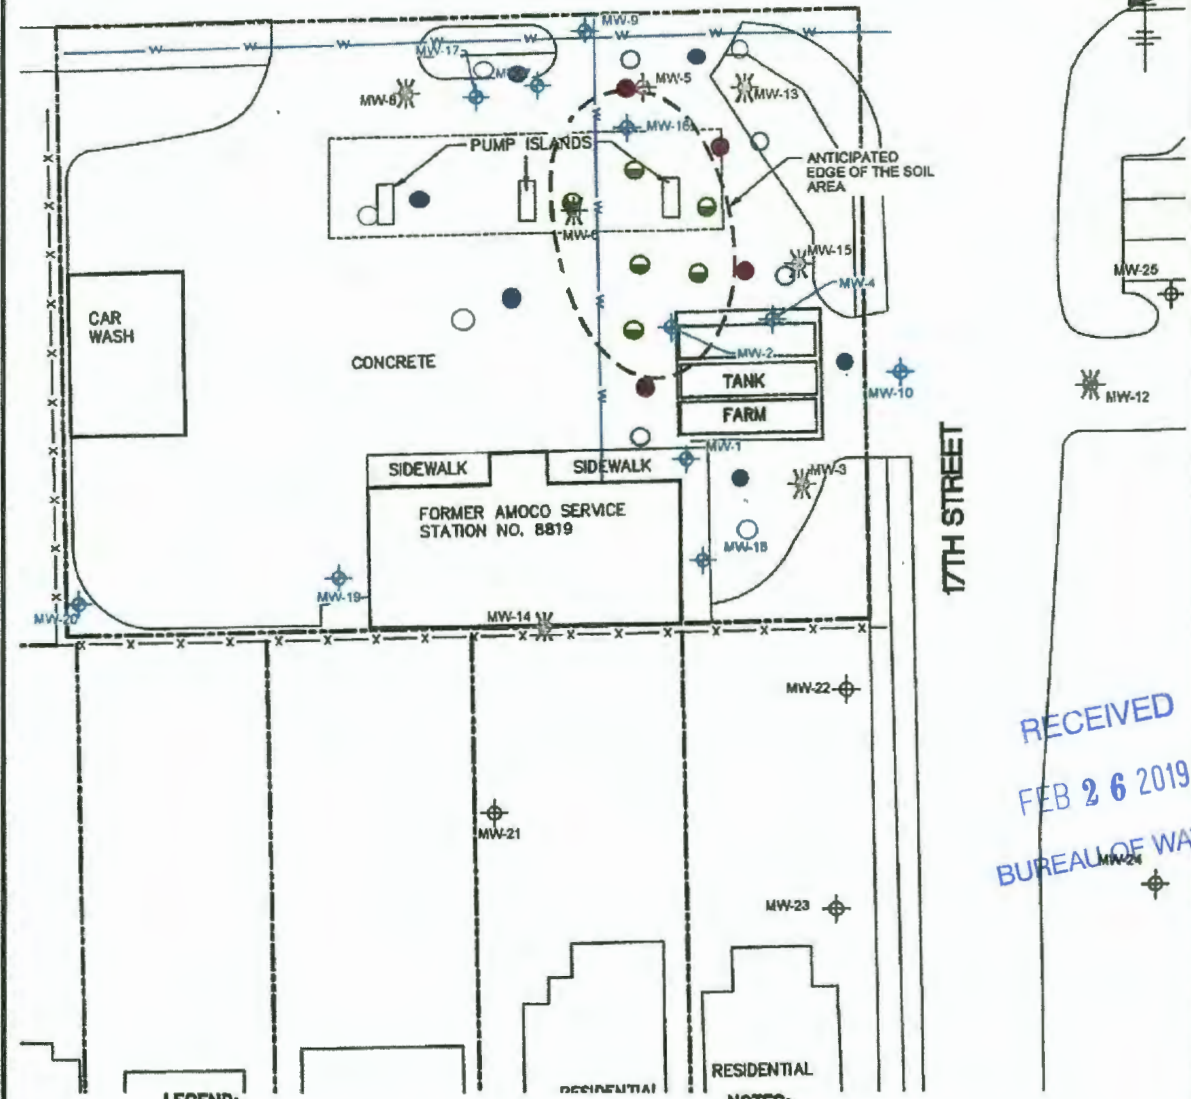

RECEIVED  
 FEB 26 2019  
 BUREAU OF WATER


- LEGEND:**
- GROUNDWATER MONITORING WELL (TO BE ABANDONED)
  - OFFSITE GROUNDWATER MONITORING WELL
  - OBSTRUCTED MONITORING WELL
  - ABANDONED WELL
  - VISUAL (V) SOIL BORING LOCATION
  - CONTINGENT (C) SOIL BORING LOCATION
  - HOLD (H) SOIL BORING LOCATION
  - FENCE LINE
  - PROPERTY BOUNDARY LINE
  - ESTIMATED WATER LINE LOCATION
  - Additional Soil Borings

**NOTES:**  
 1. ALL LOCATIONS ARE APPROXIMATE.



AMOCO, UNIVERSITY #8819  
 1701 ANDERSON AVE.  
 MANHATTAN, KANSAS  
 KDHE #U5-081-00082

**PROPOSED SOIL BORING SAMPLE LOCATIONS**



FIGURE  
**1**