

WATER WELL PLUGGING RECORD Form WWC-5P

KSA 82a-1212

ID NO.

MW-10

1 LOCATION OF WATER WELL: Fraction NE 1/4 NE 1/4 SW 1/4 NW 1/4 Section Number 18 Township Number T 10 S Range Number 8 E W
 County: Riley

Street/Rural Address of Well Location; if unknown, distance & direction from nearest town or intersection: If at owner's address, check here Former Amoco Gas Station #8819
 1701 Anderson Ave.
 Manhattan, KS


Global Positioning Systems (GPS) information:

Latitude: 38.185628 (in decimal degrees)
 Longitude: -96.583918 (in decimal degrees)
 Elevation: _____
 Horizontal Datum: WGS84, NAD83, NAD27
 Collection Method: _____

2 WATER WELL OWNER: Atlantic Richfield Company
 RR#, St. Address, Box #: 501 Westlake Park Blvd.
 City, State ZIP Code: Houston TX 77079

GPS unit (Make/Model: garim etrek)
 Digital Map/Photo, Topographic Map, Land Survey
 Est. Accuracy: < 3 m, 3-5 m, 5-15 m, > 15 m

3 MARK WELL'S LOCATION WITH AN "X" IN SECTION BOX:

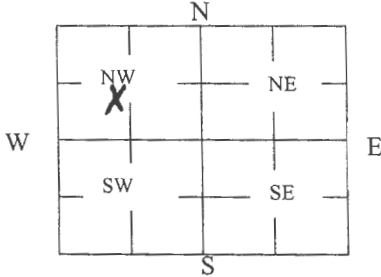

4 DEPTH OF WELL 25 ft.

WELL'S STATIC WATER LEVEL 8.9 ft

WELL WAS USED AS:

- Domestic
- Irrigation
- Feedlot
- Industrial
- Public Water Supply
- Oil Field Water Supply
- Domestic (Lawn & Garden)
- Air Conditioning
- Dewatering
- Monitoring
- Injection Well
- Other _____

Was a chemical/bacteriological sample submitted to Department? Yes No

5 TYPE OF BLANK CASING USED:

- Steel
- PVC
- RMP (SR)
- ABS
- Wrought
- Asbestos-Cement
- Fiberglass
- Concrete Tile
- Other (Specify below) _____

Blank casing diameter 2 in. Was casing pulled? Yes No If yes, how much all
 Casing height above or below land surface -6 in.

6 GROUT PLUG MATERIAL: Neat cement Cement grout Bentonite Other Top Soil

Grout Plug Intervals: From 0 ft. to 3 ft., From 3 ft. to 25 ft., From — ft. to — ft.

What is the nearest source of possible contamination:


- Septic tank
 - Sewer lines
 - Watertight sewer lines
 - Lateral lines
 - Cess pool
 - Seepage pit
 - Pit privy
 - Sewage lagoon
 - Feedyard
 - Livestock pens
 - Fuel storage
 - Fertilizer storage
 - Insecticide storage
 - Abandoned water well
 - Oil well/Gas well
 - Other (specify below) _____
- Direction from well? Southwest
 How many feet? 150

FROM	TO	PLUGGING MATERIALS	FROM	TO	PLUGGING MATERIALS
0	3	Top Soil			
3	25	Bentonite			

7 CONTRACTOR'S OR LANDOWNER'S CERTIFICATION: This water well was plugged under my jurisdiction and was completed on (mo/day/year) 2-4-2019 and this record is true to the best of my knowledge and belief. Kansas Water Well Contractor's License No. 710. This Water Well Record was completed on (mo/day/year) 2-18-19 under the business name of Below Ground Surface, Inc. by (signature) [Signature]

Send one white copy to Kansas Department of Health & Environment, Geology Section, 1000 SW Jackson Street, Ste. 420, Topeka, KS 66612-1367. Send one copy to WATER WELL OWNER and retain one for your records.
 Visit us at <http://www.kdheks.gov/waterwell/index.html> Telephone 785-296-5524.

ANDERSON AVENUE

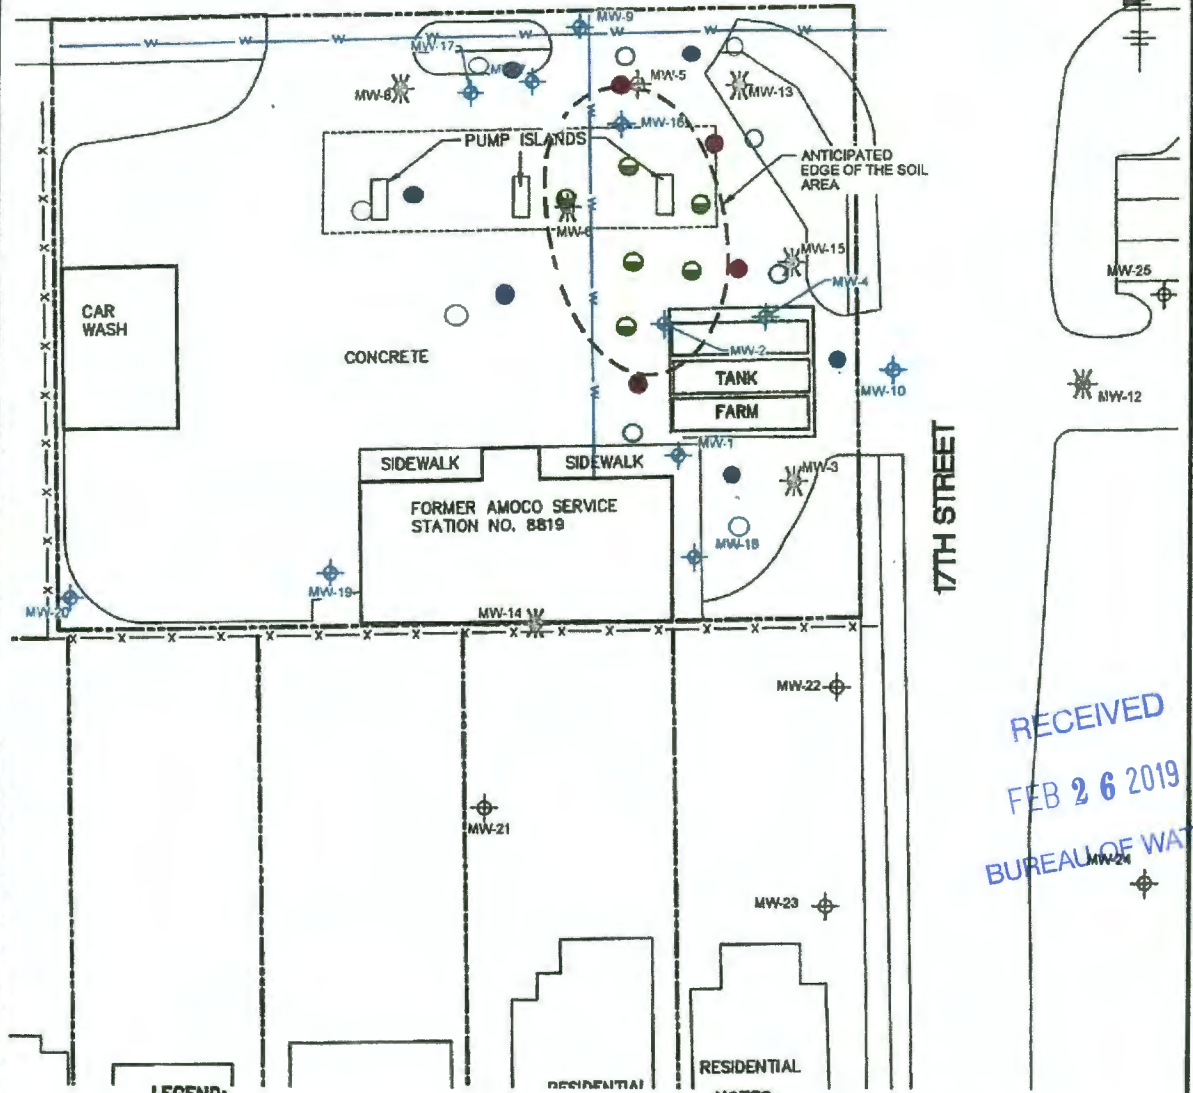


- LEGEND:**
- GROUNDWATER MONITORING WELL (TO BE ABANDONED)
 - OFFSITE GROUNDWATER MONITORING WELL
 - OBSTRUCTED MONITORING WELL
 - ABANDONED WELL
 - VISUAL (V) SOIL BORING LOCATION
 - CONTINGENT (C) SOIL BORING LOCATION
 - HOLD (H) SOIL BORING LOCATION
 - FENCE LINE
 - PROPERTY BOUNDARY LINE
 - ESTIMATED WATER LINE LOCATION
 - Additional Soil Borings

NOTES:
 1. ALL LOCATIONS ARE APPROXIMATE.



AMOCO, UNIVERSITY #8819
 1701 ANDERSON AVE.
 MANHATTAN, KANSAS
 KDHE #J5-081-00062

PROPOSED SOIL BORING SAMPLE LOCATIONS



FIGURE
1

RECEIVED
 FEB 26 2019
 BUREAU OF WATER