


WATER WELL PLUGGING RECORD Form WWC-5P KSA 82a-1212 ID NO.

1 LOCATION OF WATER WELL: Fraction 1/4 NE 1/4 NW 1/4 NE 1/4 Section Number 15 Township Number T 10 S Range Number 8 NE W

County: Pottawatomie
 Street/Rural Address of Well Location: if unknown, distance & direction from nearest town or intersection: If at owner's address, check here South of intersection of Hwy 24 and Dempsey South Yankton and 1/2 mile south east
Global Positioning Systems (GPS) information:
 Latitude: 39.188242 (in decimal degrees)
 Longitude: -96.507245 (in decimal degrees)
 Elevation: 1002 ft
 Datum: WGS84, NAD83, NAD27
 Collection Method:

2 WATER WELL OWNER: Pottawatomie RWD No. 1
 RR#, St. Address, Box #: RR 1
 City, State ZIP Code: Wamego KS. 66547
 GPS unit (Make/Model: Garmin)
 Digital Map/Photo, Topographic Map, Land Survey
 Est. Accuracy: < 3 m, 3-5 m, 5-15 m, > 15 m

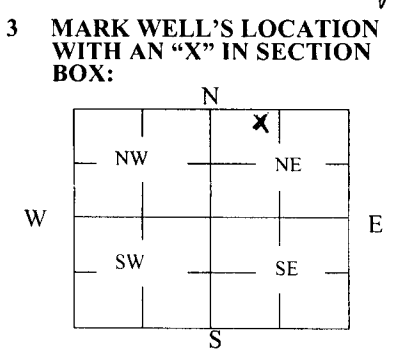

4 DEPTH OF WELL 68 ft.
 WELL'S STATIC WATER LEVEL 12 ft
 WELL WAS USED AS:
 Domestic Public Water Supply Dewatering
 Irrigation Oil Field Water Supply Monitoring
 Feedlot Domestic (Lawn & Garden) Injection Well
 Industrial Air Conditioning Other test hole
 Was a chemical/bacteriological sample submitted to Department? Yes No

5 TYPE OF BLANK CASING USED:
 Steel RMP (SR) Wrought Fiberglass Other (Specify below)
 PVC ABS Asbestos-Cement Concrete Tile
 Blank casing diameter 5 in. Was casing pulled? Yes No If yes, how much _____
 Casing height above or below land surface 18 in.

6 GROUT PLUG MATERIAL: Neat cement Cement grout Bentonite Other _____
 Grout Plug Intervals: From 36 ft. to 10 ft., From _____ ft. to _____ ft., From _____ ft. to _____ ft.
 What is the nearest source of possible contamination:
 Septic tank Seepage pit Fuel storage Other (specify below)
 Sewer lines Pit privy Fertilizer storage
 Watertight sewer lines Sewage lagoon Insecticide storage
 Lateral lines Feedyard Abandoned water well Direction from well? _____
 Cess pool Livestock pens Oil well/Gas well How many feet? _____

FROM	TO	PLUGGING MATERIALS	FROM	TO	PLUGGING MATERIALS
<u>68'</u>	<u>36'</u>	<u>Chlorinated gravel fill</u>			
<u>36'</u>	<u>10'</u>	<u>Bentonite</u>			
<u>10'</u>	<u>3'</u>	<u>Cement grout</u>			

7 CONTRACTOR'S OR LANDOWNER'S CERTIFICATION: This water well was plugged under my jurisdiction and was completed on (mo/day/year) 9/19/2019 and this record is true to the best of my knowledge and belief. Kansas Water Well Contractor's License No. 935. This Water Well Record was completed on (mo/day/year) 9/23/2019 under the business name of Alexander pump & service by (signature) [Signature]

INSTRUCTIONS: Use typewriter or ballpoint pen. Please press firmly and print clearly. Please fill in blanks, underline or circle the correct answers. Send top three copies to Kansas Department of Health and Environment, Bureau of Water, Geology Section, 1000 SW Jackson St., Ste. 420, Topeka, Kansas 66612-1367. Telephone: 785/296-5524. Send one to Water Well Owner and retain one for your records. Visit us at <http://www.kdheks.gov/waterwell/index.html>.