


LEGEND

- ◆ = Monitoring Well
 - ◆ = Public Water Well
 - ◆ = Abandoned/Destroyed Well
 - ◆ = Geoprobe Location
- All locations and boundaries are approximate

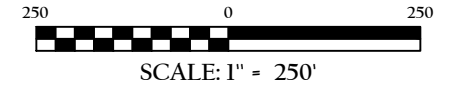

DRAWN BY:	SV
JOB#:	1874090
DATE:	02/01/2021
PROJ. MANGR:	SE

Former Cinderella Cleaners/Stickel Cleaners
 1227 Bluemont Ave./ 714 N. 12th St.
 Manhattan, KS
 KDHE #s: C5-081-70782/ C5-081-71238

SITE BASE MAP