							7			
WATER	WELL I	RECORD Form	WWC-5	Г	ivision of Wate	r	MW-29D			
			ge in Well Use	Re	Resources App. No. Well ID		Well ID			
l .		VATER WELL:	Fraction	1	ection Numbe	1 -				
	r: Riley		SW 1/4 SE 1/4 SE 1/4	SE 1/4	7	T 10 S	R 8 ■ E □ W			
2 WELL		Last Name:	First:	Street or F	treet or Rural Address where well is located (if unknown, distance and					
1	KDHE	Linglener Chront Cult	420	direction fro	irection from nearest town or intersection): If at owner's address, check here:					
Address: 1000 SW Jackson Street, Suite 420 Address:										
City:	Topeka	State: KS	ZIP: 66612-1367							
3 LOCAT				66	0	30 1806	69 (decimal degrees)			
WITH "		4 DEPTH OF COM	MPLETED WELL:	QQ	II. 5 Latiti	ide:	decimal degrees)			
SECTIO		Deptn(s) Groundwater	Encountered: 1)25 3) ft., or 4) [	?;У π. ⊐ Dry Well	D ft.       Longitude:       96.55960       (decimal degrees)         Dry Well       Horizontal Datum:       ■ WGS 84 □ NAD 83 □ NAD 27					
N	N .	WELL'S STATIC WA	TER LEVEL:19	.2 ft.	ft. Source for Latitude/Longitude:					
		below land surface	e, measured on (mo-day-	yr).12-17-20			<u></u> )			
NW	NE	☐ above land surface	e, measured on (mo-day-	·yr)		(WAAS enabled?				
			vater was f			and Survey   Topogr				
w	E		s pumping			nline Mapper:				
sw	SE		water was 1							
	1 x	Fetimated Vield:	rs pumping	gpiii	6 Eleva	tion: 1010.18 f	t. 🗌 Ground Level 🔳 TOC			
	S	Bore Hole Diameter:	8.75 in. to 66	ft. and	Source	e: 🔳 Land Survey 🔲	GPS  Topographic Map			
1 n		Bote Hote Blameter.	in. to	ft.		☐ Other				
7 WELL V	WATER T	O BE USED AS:								
1. Domestic:			ater Supply: well ID		10. 🗌 Oi	1 Field Water Supply: 1	lease			
☐ Housel	hold	<ol><li>Dewatering</li></ol>	ng: how many wells?							
☐ Lawn &		7. 🔲 Aquifer F	Recharge: well ID		🔲 Ca	ised Uncased				
Livesto					12. Geoth	nermal: how many bore	es?			
2. ☐ Irrigati 3. ☐ Feedlo			tal Remediation: well II		. a) Cl	osed Loop  Horizon	bischarge  Inj. of Water			
4. Industr		☐ Recovery	ge Soil Vapor I	Extraction						
						` <b>.</b> • ·				
Was a cnel	micai/Dacte	eriological sample subt ?   Yes  No	nitted to KDHE?	Yes N	o II yes, date	e sample was submitte	ed:			
e Type o	UISIIIIECIEU	CHCED. Carel D	7C 🗆 Oth	CA	ING IONTS	· Clued Clampa	ed  Welded  Threaded			
Casing diam	oeter 2	in. to	Otner	in to	OINIO JUINIS Dian	eter in to	ed   weided   Timeaded			
Casing train	ht above land	surface 0 i	, Diametei n Weight	lhs /f	Wall thick	ness or gauge No. SCh	1 40			
		R PERFORATION MA		100., 1	. Wan inte	areso or gauge 1 to 1 this				
☐ Steel		inless Steel  Fibe			□ Otl	ner (Specify)				
Brass			_	used (open h		(-1 - 3)				
SCREEN C	OR PERFO	RATION OPENINGS A	ARE:							
		■ Mill Slot □ C								
		☐ Key Punched ☐ V								
		TED INTERVALS: From								
GRAVEL PACK INTERVALS: From										
9 GROUI	MATERI	AL: Neat cement L 1 ft. to .54	Cement grout Be	entonite <b>E</b>	Other Oction	iii pau	Δ			
		ole contamination:	II., From <b>V</b>	п. ю	It., From	11. 10	11.			
☐ Septic		☐ Lateral Lin	es		Livestock Pe	ens	icide Storage			
Sewer		☐ Cess Pool	☐ Sewage La		☐ Fuel Storage		doned Water Well			
☐ Watert	ight Sewer L			Č	Fertilizer Sto		ell/Gas Well			
■ Other (Specify) Dry Cleaners  Direction from well? east west Distance from well? 100 ft. ft.										
						f				
10 FROM	TO	LITHOLO	GIC LOG	FROM	TO		or PLUGGING INTERVALS			
0	1	Topsoil	1 . 1	30		Sand, dark gray, co				
1	5	Sandy Soil, dark brow		45		Sand, dark brown,				
5	10	Sandy Clay, dark bro	wn to dark gray,	60	66	Sand & Gravel, bro	own, coarse, saturated			
10	15	moist, plastic	iot plactic							
10	15	Silty Clay, brown, mo								
15	20	Silty Clay, dark gray,	very moist, slight	BT-4						
20	25	petroleum odor		Notes:						
20	25	Sand & Clay, dark br								
25 30 Sand, dark brown, saturated 11 CONTRACTOR'S OR LANDOWNER'S CERTIFICATION: This water well was ■ constructed, □ reconstructed, or □ plugg										
under my jurisdiction and was completed on (mo-day-year) .12-16-2021 and this record is true to the best of my knowledge and belief.										
Kansas Wa	ater Well Co	ontractor's License No.	604 This W	ater Well I	Record was con	mpleted on (mo-day-	year) .2./.14./2Z			
under the b	ousiness nar	ne of Environmental I	Priority Service, Inc.		Signature	I M YT				
Mail	Mail 1 white copy along with a fee of \$5.00 for each constructed well to: Kansas Department of Health and Environment, Bureau of Water, GWTS Section, 1000 SW Jackson St., Suite 420, Topeka, Kansas 66612-1367. Mail one to Water Well Owner and retain one for your records. Telephone 785-296-5524.									
			s 66612-1367. Mail one to	Water Well	Owner and retain o	one for your records. Telep	phone 785-296-5524.			
Visit us at htt	p://www.kdhe	ks.gov/waterwell/index.html		KSA 82a	1212		Revised 7/10/2015			

## RECEIVED

## **DENNIS L HANDKE**

FEB 3 3 2022

BUREAU OF WATER

1820 NW 59th Terrace TOPEKA, KANSAS 66618 785-286-4047 Home

Jonathan Polak
Habitat Architects
3904 East 185<sup>th</sup> Street
Belton, Missouri 64012

January 21, 2022

RE: Monitor Well Elevation Survey Manhattan, Kansas

Proj. 22-00B Cinderella Cleaners and Stickel Cleaners C5-081-70782

Bench Mark: Chisled Square on NE corner of concrete signal light base at NE corner of Hayes Dr. & McCall Rd.


McCall Rd. Elev: 1008.24

North 55.35

West 4591.88

(from SE Cor. Sec. 8-10-8E)

√MW-29S	rim	1010.73	North	65.34	SW1/4,SE1/4,SE1/4,SE1/4 (Sec. 7-10-8E)
	top pipe	1010.20	West	5976.67	Lat= 39.18970 Long = 96.55960
√MW-29D	rim	1010.73	North	61.72	SW1/4,SE1/4,SE1/4,SE1/4 (Sec. 7-10-8E)
	top pipe	1010.18	West	5975.27	Lat= 39.18969 Long = 96.55960
√MW-30S	rim	1010.09	North	251.08	SE1/4,SE1/4,SE1/4,SE1/4 (Sec. 7-10-8E)
	top pipe	1009.60	West	5556.11	Lat= 39.19020 Long = 96.55812
$\sqrt{_{\text{MW-30D}}}$	rim	1010.05	North	248.38	SE1/4,SE1/4,SE1/4,SE1/4 (Sec. 7-10-8E)
	top pipe	1009.60	West	5556.76	Lat= 39.19021 Long = 96.55812
√MW-31S	rim	1010.25	North	180.76	SE1/4,SE1/4,SE1/4,SE1/4 (Sec. 7-10-8E)
	top pipe	1009.61	West	5546.39	Lat= 39.19002 Long = 96.55808
√MW-31D	rim	1010.02	North	176.86	SE1/4,SE1/4,SE1/4,SE1/4 (Sec. 7-10-8E)
	top pipe	1009.53	West	5545.84	Lat= 39.19000 Long = 96.55808
√MW-32S	rim top pipe	1007.35 1006.84	North West		NE1/4,SW1/4,SW1/4,SW1/4 Lat= 39.19119 Long = 96.55512
√MW-32D	rim	1007.35	North	603.93	NE1/4,SW1/4,SW1/4,SW1/4
	top pipe	1006.84	West	4705.04	Lat= 39.19119 Long = 96.55510
√MW-33S	rim	1007.70	North	892.90	SW1/4,NE1/4,SW1/4,SW1/4
	top pipe	1007.06	West	4610.81	Lat= 39.19198 Long = 96.55479
/ <sub>MW-33D</sub>	rim	1007.68	North	893.13	SW1/4,NE1/4,SW1/4,SW1/4
	top pipe	1007.12	West	4606.23	Lat= 39.19198 Long = 96.55477
MW-34S	rim	1007.54	North	1288.87	NE1/4,NE1/4,SW1/4,SW1/4
	top pipe	1006.97	West	4624.71	Lat= 39.19307 Long = 96.55483
MW-34D	rim	1007.42	North	1289.06	NE1/4,NE1/4,SW1/4,SW1/4
	top pipe	1006.92	West	4621.09	Lat= 39.19307 Long = 96.55484

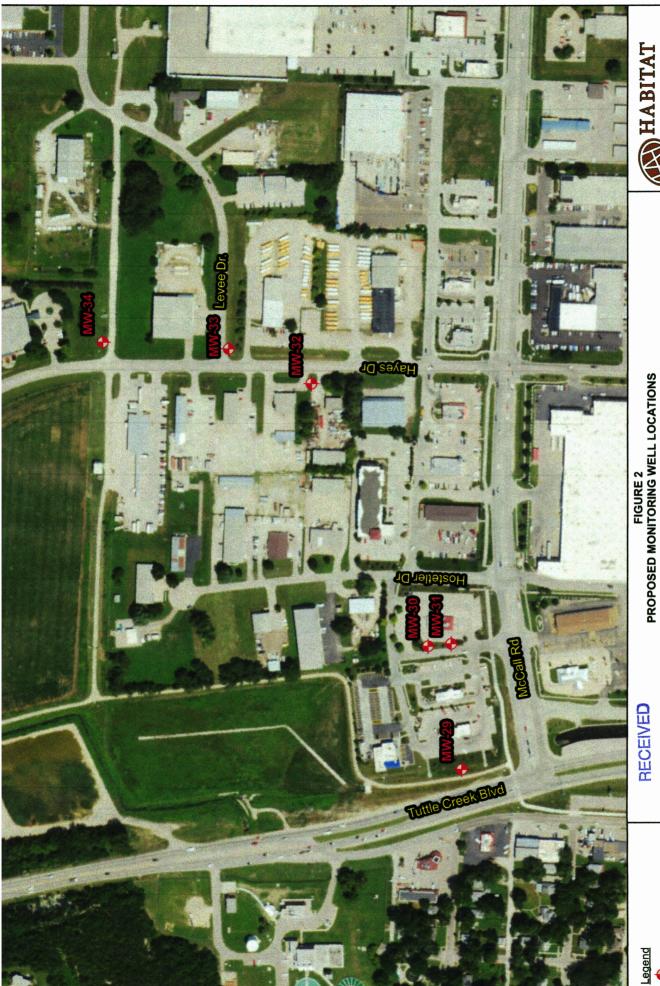

HABITAT

Drawn By: R Bath

Project Manager: J Polak

Date: 08/30/2021

KDHE#: C5-081-70782

CINDERELLA CLEANERS and STICKEL CLEANERS MANHATTAN, KANSAS

Source: NAIP 2019 || Location: SE 1/4 of Sec 7 and the SW 1/4 of Sec 8 - T10S - R8E, Riley County and Pottawatomie County, KS

NORTH

BUREAU OF WATER

Proposed Monitoring Well

egend

RECEIVED

150 1 in. = 300 ft.