



# DENNIS L HANDKE

1820 NW 59th Terrace  
TOPEKA, KANSAS 66618  
785-286-4047 Home

Charlotte Phillip  
112 SW 6<sup>th</sup> Street, Suite 201  
Topeka, Kansas, 66603

T. 10 R.8E Sec. 19  
Riley County

April 18, 2023

RE: Monitor Well Elevation Survey  
605 S. 3<sup>rd</sup> St., Manhattan, Kansas

Proj. 23-00M  
MKC - Manhattan  
A5-081-40499


Bench Mark: Chisled X on top of the NE bolt on the North leg of the Casey's sign base near the NW Corner of property.

Elev:		North 5250	West 796	(from SE Cor. Sec. 19-10-8E)
MW-1	rim	1014.90	North 5226	NE1/4,NW1/4,NE 1/4,NE1/4
	top pipe	1014.61	West 759	Lat= 39.17395 Long = 96.56001
MW-2	rim	1015.63	North 5233	NE1/4,NW1/4,NE1/4,NE1/4
	top pipe	1015.03	West 808	Lat= 39.17396 Long = 96.56018
MW-3	rim	1015.76	North 5079	NE1/4,NW1/4,NE1/4,NE1/4
	top pipe	1015.03	West 711	Lat= 39.17354 Long = 96.56983
MW-4	rim	1015.55	North 5178	NE1/4,NW1/4,NE1/4,NE1/4
	top pipe	1015.31	West 777	Lat= 39.17382 Long = 96.56007
MW-5	rim	1015.75	North 5130	NE1/4,NW1/4,NE1/4,NE1/4
	top pipe	1015.19	West 816	Lat= 39.17368 Long = 96.56021
MW-6	rim	1014.89	North 5075	NE1/4,NW1/4,NE1/4,NE1/4
	top pipe	1014.64	West 824	Lat= 39.17353 Long = 96.56023
MW-7	rim	1016.87	North 5123	NW1/4,NE1/4,NE1/4,NE1/4
	top pipe	1016.25	West 646	Lat= 39.17367 Long = 96.55960
MW-8	rim	1015.40	North 5164	NW1/4,NE1/4,NE1/4,NE1/4
	top pipe	1015.01	West 631	Lat= 39.17378 Long = 96.55955
MW-9	rim	1015.01	North 5258	NE1/4,NW1/4,NE1/4,NE1/4
	top pipe	1014.47	West 692	Lat= 39.17404 Long = 96.55977

Lat & Long derived from Manhattan 7.5' quad map. WGS84

Elevation established from NGS BM FF 115. NAVD 88

If you have any questions, please feel free to call me. Thank you for the opportunity to be of service to you.

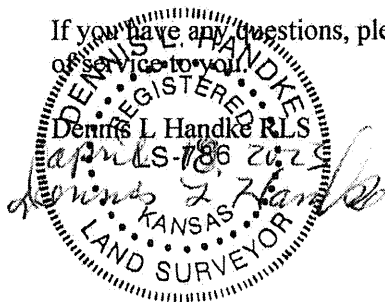





DESIGNED BY:	CP
DRAWN BY:	CP
CHECKED BY:	RW
APPROVED BY:	CC
DATE:	FEBRUARY 2023



MW Location Site Map  
Oppy's Rental



605 S 3rd Street  
Manhattan, Kansas  
A5-081-40499

**FIGURE**  
**1**

**Limited Site  
Assessment  
DRAFT**