

Correction

WATER WELL RECORD Form WWC-5

Original Record Correction Change in Well Use

Division of Water Resources App. No.

Well ID

MW-9

1 LOCATION OF WATER WELL: County: Riley Fraction NE 1/4 NW 1/4 NE 1/4 SE 1/4 Section Number 19 Township Number T 10 S Range Number R 8 E W

2 WELL OWNER: Oppy's Rental LLC Business: 14815 Lake Crossing Rd. Wamego, Ks. 66547 Street or Rural Address where well is located (if unknown, distance and direction from nearest town or intersection): If at owner's address, check here: 605 S. 3rd Street, Manhattan, Ks.

3 LOCATE WELL WITH 'X' IN SECTION BOX: N W E S

4 DEPTH OF COMPLETED WELL: 33 ft. Depth(s) Groundwater Encountered: 1) 22.9 ft. 2) ft. 3) ft. or 4) Dry Well WELL'S STATIC WATER LEVEL: 22.19 ft. below land surface, measured on (mo-day-yr) 3-14-2023

5 Latitude: 39.17404 (decimal degrees) Longitude: -96.55977 (decimal degrees) Horizontal Datum: WGS 84 NAD 83 NAD 27 Source for Latitude/Longitude: GPS (unit make/model) (WAAS enabled? Yes No) Land Survey Topographic Map Online Mapper

6 Elevation: 1014.47 ft. Ground Level TOC Source: Land Survey GPS Topographic Map Other

7 WELL WATER TO BE USED AS: 1. Domestic: Household Lawn & Garden Livestock Irrigation Feedlot Industrial 5. Public Water Supply: well ID 6. Dewatering: how many wells? 7. Aquifer Recharge: well ID 8. Monitoring: well ID MW-9 9. Environmental Remediation: well ID Air Sparge Soil Vapor Extraction Recovery Injection 10. Oil Field Water Supply: lease 11. Test Hole: well ID Cased Uncased Geotechnical 12. Geothermal: how many bores? a) Closed Loop Horizontal Vertical b) Open Loop Surface Discharge Inj. of Water 13. Other (specify):

Was a chemical/bacteriological sample submitted to KDHE? Yes No If yes, date sample was submitted: Water well disinfected? Yes No

8 TYPE OF CASING USED: Steel PVC Other CASING JOINTS: Glued Clamped Welded Threaded Casing diameter 2 in. to 18 ft., Diameter in. to ft., Diameter in. to ft. Casing height above land surface 0 in. Weight lbs./ft. Wall thickness or gauge No. sch 40 TYPE OF SCREEN OR PERFORATION MATERIAL: Steel Stainless Steel Fiberglass PVC Brass Galvanized Steel Concrete tile None used (open hole) SCREEN OR PERFORATION OPENINGS ARE: Continuous Slot Mill Slot Gauze Wrapped Torch Cut Drilled Holes Other (Specify) Louvered Shutter Key Punched Wire Wrapped Saw Cut None (Open Hole) SCREEN-PERFORATED INTERVALS: From 18 ft. to 33 ft., From ft. to ft., From ft. to ft. GRAVEL PACK INTERVALS: From 16 ft. to 33 ft., From ft. to ft., From ft. to ft.

9 GROUT MATERIAL: Neat cement Cement grout Bentonite Other cement pad Grout Intervals: From 1 ft. to 16 ft., From 0 ft. to 1 ft., From ft. to ft. Nearest source of possible contamination: Septic Tank Lateral Lines Pit Privy Livestock Pens Insecticide Storage Sewer Lines Cess Pool Sewage Lagoon Fuel Storage Abandoned Water Well Watertight Sewer Lines Seepage Pit Feedyard Fertilizer Storage Oil Well/Gas Well Other (Specify) contaminated site Direction from well? Distance from well? ft.

Table with 6 columns: 10 FROM, TO, LITHOLOGIC LOG, FROM, TO, LITHO. LOG (cont.) or PLUGGING INTERVALS. Rows show depth intervals and lithology: 0-10 ft Sand, light brown, fine, moist, silty in part; 10-23 ft Sand, light brown to gray, fine to medium moist; 23-25 ft Sand, light brown, medium to coarse, mo; 25-33 ft Sand, gray brown, coarse, wet to saturate

11 CONTRACTOR'S OR LANDOWNER'S CERTIFICATION: This water well was constructed, reconstructed, or plugged under my jurisdiction and was completed on (mo-day-year) 3-7-2023 and this record is true to the best of my knowledge and belief. Kansas Water Well Contractor's License No. 604 This Water Well Record was completed on (mo-day-year) 4-28-23 under the business name of Environmental Priority Service, Inc. Signature [Signature]

DENNIS L HANDKE

1820 NW 59th Terrace
TOPEKA, KANSAS 66618
785-286-4047 Home

Charlotte Phillip
112 SW 6th Street, Suite 201
Topeka, Kansas, 66603

T. 10 R.8E Sec. 19
Riley County

April 18, 2023

RE: Monitor Well Elevation Survey
605 S. 3rd St., Manhattan, Kansas

Proj. 23-00M
MKC - Manhattan
A5-081-40499


Bench Mark: Chisled X on top of the NE bolt on the North leg of the Casey's sign base near the NW Corner of property.

Elev:		North 5250	West 796	(from SE Cor. Sec. 19-10-8E)
MW-1	rim	1014.90	North 5226	NE1/4,NW1/4,NE 1/4,NE1/4
	top pipe	1014.61	West 759	Lat= 39.17395 Long = 96.56001
MW-2	rim	1015.63	North 5233	NE1/4,NW1/4,NE1/4,NE1/4
	top pipe	1015.03	West 808	Lat= 39.17396 Long = 96.56018
MW-3	rim	1015.76	North 5079	NE1/4,NW1/4,NE1/4,NE1/4
	top pipe	1015.03	West 711	Lat= 39.17354 Long = 96.56983
MW-4	rim	1015.55	North 5178	NE1/4,NW1/4,NE1/4,NE1/4
	top pipe	1015.31	West 777	Lat= 39.17382 Long = 96.56007
MW-5	rim	1015.75	North 5130	NE1/4,NW1/4,NE1/4,NE1/4
	top pipe	1015.19	West 816	Lat= 39.17368 Long = 96.56021
MW-6	rim	1014.89	North 5075	NE1/4,NW1/4,NE1/4,NE1/4
	top pipe	1014.64	West 824	Lat= 39.17353 Long = 96.56023
MW-7	rim	1016.87	North 5123	NW1/4,NE1/4,NE1/4,NE1/4
	top pipe	1016.25	West 646	Lat= 39.17367 Long = 96.55960
MW-8	rim	1015.40	North 5164	NW1/4,NE1/4,NE1/4,NE1/4
	top pipe	1015.01	West 631	Lat= 39.17378 Long = 96.55955
MW-9	rim	1015.01	North 5258	NE1/4,NW1/4,NE1/4,NE1/4
	top pipe	1014.47	West 692	Lat= 39.17404 Long = 96.55977

Lat & Long derived from Manhattan 7.5' quad map. WGS84

Elevation established from NGS BM FF 115. NAVD 88

If you have any questions, please feel free to call me. Thank you for the opportunity to be of service to you.

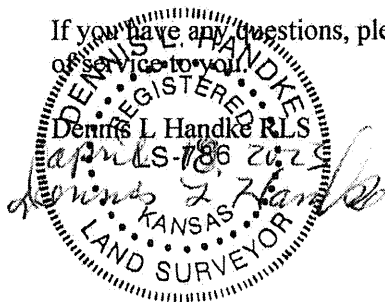



DESIGNED BY:	CP
DRAWN BY:	CP
CHECKED BY:	RW
APPROVED BY:	CC
DATE:	FEBRUARY 2023



MW Location Site Map
Oppy's Rental



605 S 3rd Street
Manhattan, Kansas
A5-081-40499

FIGURE
1

**Limited Site
Assessment
DRAFT**