

USE TYPEWRITER OR BALL POINT PEN-PRESS FIRMLY, PRINT CLEARLY.



WATER WELL RECORD  
KSA 82a-1201-1215

T R EW sec 1/4 1/4 1/4 No.

Kansas State Dept. Of Health  
(Water Well Contractors)  
Forbes-Bldg. 740  
Topeka, Kansas 66620

1 Location of well: County RILEY Township name Riley Fraction NE 1/4 - NE 1/4 - NW 1/4 Section number 14 Town number 10 Range number 17 E

Distance and direction from nearest town or city: 3 NE OF MANHATTAN  
Street address of well location if in city: 2012 ROGERS BLVD. MANHATTAN KS.  
3 Owner of well: Duane Gilliam CONSTRUCTION  
Address: 2012 ROGERS BLVD. MANHATTAN KS.

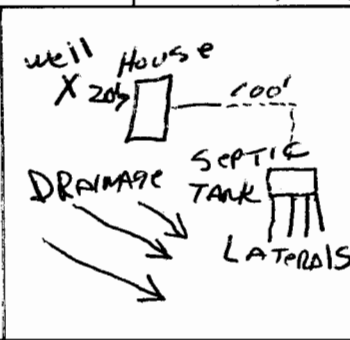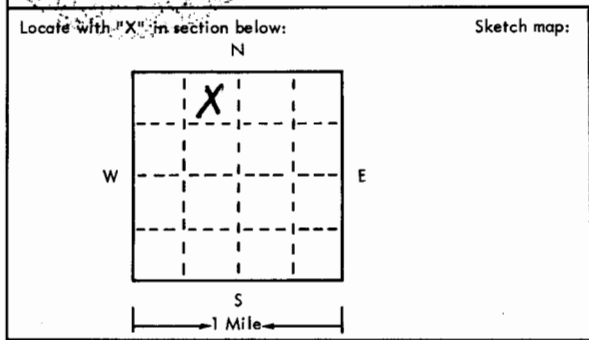

4 Well depth: 240 ft. Date of completion 9-11-75  
Well diameter 8 in.  
5  Cable tool  Rotary  Driven  Dug  
 Hollow rod  Jetted  Bored  Reverse rotary  
6 Use:  Domestic  Public supply  Industry  
 Irrigation  Air conditioning  Commercial  
 Test well   
7 Casing: Material PVC Height: above/below  
Threaded  Welded  Surface 24 in.  
Diam. 5 in. Weight 2.32 lbs./ft.  
5 in. to 240 ft. depth Drive shoe?  Yes  No  
    in. to     ft. depth

2	Type and color of material	From	To
	Top Soil	0	1
	yellow shale	1	12
	Red shale	12	25
	Grey lime	25	60
	Grey shale	60	133
	Grey limestone	133	136
	Grey shale	136	161
	Soft yellow limestone	161	175
	Red shale	175	190
	Grey limestone	190	202
	Grey shale	202	229
	Grey limestone	229	238
	Grey shale	238	240

8 Screen: Manufacturer Pumpco  
Type PVC Dia. 5"  
Slot/gauge 1080 Length 40'  
Set between 160 ft. and 180 ft.  
Fittings: 220 - 240  
Gravel pack  Yes  No Size range of material 1/2 x 1/8  
9 Static water level: NOT MEASURED  
160 ft. below land surface Date 9-11-75 WWC  
10 Pumping level below land surfaces: AIR TEST  
    ft. after     hrs. pumping     g.p.m.  
    ft. after     hrs. pumping     g.p.m.  
Estimated maximum yield 10 g.p.m.  
11 Water sample submitted:  
 Yes  No Date      
12 Well head completion: CAPPED  
 Pitless adapter 24  Inches above grade  
13 Well grouted?  Yes  No  
 Neat cement  Bentonite   
Depth: From 0 ft. to 10 ft.  
14 Nearest source of possible contamination:  
ft. 100 Direction S.W Type S. Tank  
Well disinfected upon completion?  Yes  No  
15 Pump:  Not installed  
Manufacturer's name      
Model number     HP     Volts      
Length of drop pipe     ft. capacity     g.m.p.  
Type:  
 Submersible  Turbine  
 Jet  Reciprocating  
 Centrifugal  Other

16 Remarks: elevation Owner to install slab  
Topography:  
 Hill  
 Slope  
 Upland  
 Valley

17 Water well contractor's certification:  
This well was drilled under my jurisdiction and this report is true to the best of my knowledge and belief.  
Stader Dalg Co Inc 182  
Business name License No.  
Address REDI HOLTON KS  
Signed Dale Palmer Date 9-14-75  
Authorized representative

10 SE 14 NE NE NW