


CITY PROPERTY Having Trouble Getting Legal Description

1 LOCATION OF WATER WELL: County: Riley Fraction:  $\frac{1}{4}$  NE  $\frac{1}{4}$  SW  $\frac{1}{4}$  Section Number: 15 Township Number: T 10 S Range Number: R 8 EW

Distance and direction from nearest town or city street address of well if located within city? From Manhattan City Limits Go 2 miles EAST ON Highway 18 To Township Road & Go 1 mile North & Then Go  $\frac{1}{2}$  mile East on Township Road

2 WATER WELL OWNER: CITY OF MANHATTAN  
 RR#, St. Address, Box #: CITY OFFICE  
 City, State, ZIP Code: Manhattan, Kansas 66502  
 Board of Agriculture, Division of Water Resources  
 Application Number:

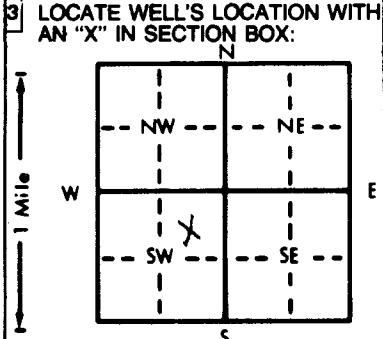

4 DEPTH OF COMPLETED WELL: 40 ft. ELEVATION: .....  
 Depth(s) Groundwater Encountered 1. 16 ft. 2. .... ft. 3. .... ft.  
 WELL'S STATIC WATER LEVEL: 16 ft. below land surface measured on mo/day/yr  
 Pump test data: Well water was ..... ft. after ..... hours pumping ..... gpm  
 Est. Yield: 60 gpm: Well water was ..... ft. after ..... hours pumping ..... gpm  
 Bore Hole Diameter: 10 in. to 40 in. to ..... in. to ..... in. to ..... ft.  
 WELL WATER TO BE USED AS:  
 1 Domestic (circled) 3 Feedlot 6 Oil field water supply 9 Dewatering 12 Other (Specify below)  
 2 Irrigation 4 Industrial 7 Lawn and garden only 10 Observation well  
 Was a chemical/bacteriological sample submitted to Department? Yes.....No...X.....; If yes, mo/day/yr sample was submitted  
 Water Well Disinfected? Yes X No

5 TYPE OF BLANK CASING USED:  
 1 Steel (circled) 3 RMP (SR) 5 Wrought iron 8 Concrete tile CASING JOINTS: Glued X Clamped  
 2 PVC (circled) 4 ABS 6 Asbestos-Cement 9 Other (specify below) Welded X Screwned  
 7 Fiberglass Threaded  
 Blank casing diameter: 5 in. to 20 in. to ..... ft., Dia. .... in. to ..... ft., Dia. .... in. to ..... ft.  
 Casing height above land surface: 18 in., weight: See 40 lbs./ft. Wall thickness or gauge No. ....  
 TYPE OF SCREEN OR PERFORATION MATERIAL:  
 1 Steel 3 Stainless steel 5 Fiberglass 7 PVC (circled) 10 Asbestos-cement  
 2 Brass 4 Galvanized steel 6 Concrete tile 8 RMP (SR) 11 Other (specify) .....  
 9 ABS 12 None used (open hole)  
 SCREEN OR PERFORATION OPENINGS ARE:  
 1 Continuous slot 3 Mill slot (circled) 16,1000 5 Gauzed wrapped 8 Saw cut 11 None (open hole)  
 2 Louvered shutter 4 Key punched 6 Wire wrapped 9 Drilled holes  
 7 Torch cut 10 Other (specify) .....  
 SCREEN-PERFORATED INTERVALS: From 20 ft. to 40 ft., From ..... ft. to ..... ft.  
 From ..... ft. to ..... ft., From ..... ft. to ..... ft.  
 GRAVEL PACK INTERVALS: From 20 ft. to 40 ft., From ..... ft. to ..... ft.  
 From ..... ft. to ..... ft., From ..... ft. to ..... ft.

6 GROUT MATERIAL: 1 Neat cement 2 Cement grout 3 Bentonite (circled) 4 Other .....  
 Grout Intervals: From 0 ft. to 20 ft., From ..... ft. to Edwards ft., From ..... ft. to ..... ft.  
 What is the nearest source of possible contamination:  
 1 Septic tank 4 Lateral lines (circled) 7 Pit privy 10 Livestock pens 14 Abandoned water well  
 2 Sewer lines 5 Cess pool 8 Sewage lagoon 11 Fuel storage 15 Oil well/Gas well  
 3 Watertight sewer lines 6 Seepage pit 9 Feedyard 12 Fertilizer storage 16 Other (specify below)  
 13 Insecticide storage  
 Direction from well? South East How many feet? 80

FROM	TO	LITHOLOGIC LOG	FROM	TO	LITHOLOGIC LOG
0	10	Clay			
10	15	Silty Clay			
15	18	Fine Sand			
18	30	Coarse Sand			
30	37	Coarse Sand & Fine Gravel			
37	40	Blue Shale			

7 CONTRACTOR'S OR LANDOWNER'S CERTIFICATION: This water well was (1) constructed, (2) reconstructed, or (3) plugged under my jurisdiction and was completed on (mo/day/year) 2/19/88 and this record is true to the best of my knowledge and belief. Kansas Water Well Contractor's License No. 451 This Water Well Record was completed on (mo/day/yr) 3/19/88 under the business name of Holdeman Well Drilling by (signature) Craig Holdeman

INSTRUCTIONS: Use typewriter or ball point pen. PLEASE PRESS FIRMLY and PRINT clearly. Please fill in blanks, underline or circle the correct answers. Send top three copies to Kansas Department of Health and Environment, Bureau of Water Protection, Topeka, Kansas 66620-7320, Telephone: 913-862-9360. Send one to WATER WELL OWNER and retain one for your records.

OFFICE USE ONLY  
T  
R  
EW  
SEC.