


MW 6

1 LOCATION OF WATER WELL: Fraction NW 1/4 NE 1/4 SE 1/4 Section Number 18 Township Number T 10 R 8 Range Number 8

Distance and direction from nearest town or city street address of well if located within city? NW Lawrence

2 WATER WELL OWNER: Goebel - Irvine Chrysler RR#, St. Address, Box #: P.O. Box 707 City, State, ZIP Code: Manhattan, KS 66502 Board of Agriculture, Division of Water Resources Application Number:

3 LOCATE WELL'S LOCATION WITH AN "X" IN SECTION BOX: 4 DEPTH OF COMPLETED WELL: 19.4 ft. ELEVATION: 1016.3

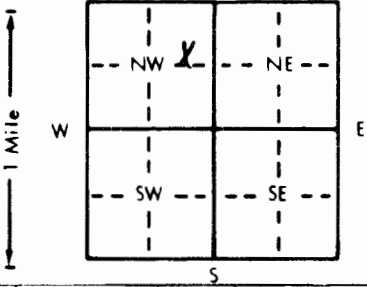

Depth(s) Groundwater Encountered 1. 15 ft. 2. ft. 3. ft. WELL'S STATIC WATER LEVEL 18.6 ft. below land surface measured on mo/day/yr 02-20-94 Pump test data: Well water was ft. after hours pumping gpm Est. Yield gpm: Well water was ft. after hours pumping gpm Bore Hole Diameter 8 in. to ft. and in. to ft. WELL WATER TO BE USED AS: 5 Public water supply 8 Air conditioning 11 Injection well 1 Domestic 3 Feedlot 6 Oil field water supply 9 Dewatering 12 Other (Specify below) 2 Irrigation 4 Industrial 7 Lawn and garden only Monitoring well Was a chemical/bacteriological sample submitted to Department? Yes No If yes, mo/day/yr sample was submitted Water Well Disinfected? Yes No

5 TYPE OF BLANK CASING USED: 1 Steel 3 RMP (SR) 5 Wrought iron 8 Concrete tile CASING JOINTS: Glued Clamped 2 PVC 4 ABS 6 Asbestos-Cement 9 Other (specify below) Welded 7 Fiberglass Threaded Blank casing diameter 2 in. to 10 ft., Dia in. to ft., Dia in. to ft. Casing height above land surface in., weight lbs./ft. Wall thickness or gauge No.

TYPE OF SCREEN OR PERFORATION MATERIAL: 1 Steel 3 Stainless steel 5 Fiberglass 8 RMP (SR) 10 Asbestos-cement 2 Brass 4 Galvanized steel 6 Concrete tile 9 ABS 12 None used (open hole)

SCREEN OR PERFORATION OPENINGS ARE: 1 Continuous slot Mill slot 5 Gauzed wrapped 8 Saw cut 11 None (open hole) 2 Louvered shutter 4 Key punched 6 Wire wrapped 9 Drilled holes 7 Torch cut 10 Other (specify)

SCREEN-PERFORATED INTERVALS: From 10 ft. to 20 ft. From ft. to ft. From ft. to ft. From ft. to ft. GRAVEL PACK INTERVALS: From 8 ft. to 20 ft. From ft. to ft. From ft. to ft. From ft. to ft.

6 GROUT MATERIAL: 1 Neat cement 2 Cement grout 3 Bentonite 4 Other Grout Intervals: From 0 ft. to 8 ft. From ft. to ft. From ft. to ft. From ft. to ft.

What is the nearest source of possible contamination: 1 Septic tank 4 Lateral lines 7 Pit privy 10 Livestock pens 14 Abandoned water well 2 Sewer lines 5 Cess pool 8 Sewage lagoon 12 Fertilizer storage 15 Oil well/Gas well 3 Watertight sewer lines 6 Seepage pit 9 Feedyard 13 Insecticide storage 16 Other (specify below)

Direction from well? NE How many feet?

FROM	TO	LITHOLOGIC LOG	FROM	TO	PLUGGING INTERVALS
0	.5	Asphalt			
.5	10	Soft brn silt & fine sand			
10	11	Soft brn silty clay			
11	20	Loose, tan, fine sand			

7 CONTRACTOR'S OR LANDOWNER'S CERTIFICATION: This water well was (1) constructed, (2) reconstructed, or (3) plugged under my jurisdiction and was completed on (mo/day/year) 11-23-93 and this record is true to the best of my knowledge and belief. Kansas Water Well Contractor's License No. 529 This Water Well Record was completed on (mo/day/yr) 04-15-94 under the business name of Geotechnology, Inc. by (signature) N. Baldwin

OFFICE USE ONLY T R E W SEC. 1/4 1/4 1/4