


MW-1

1 LOCATION OF WATER WELL: County: Riley Fraction: NW 1/4 NE 1/4 SE 1/4 Section Number: 18 Township Number: T 10 S Range Number: R 8 E

Distance and direction from nearest town or city street address of well if located within city?
4th + Leavenworth

2 WATER WELL OWNER: Goetsch-Irvine Chrysler
RR#, St. Address, Box #: 4th + Leavenworth P.O. Box 707
City, State, ZIP Code: Manhattan, Ks 66502
Board of Agriculture, Division of Water Resources
Application Number:

3 LOCATE WELL'S LOCATION WITH AN "X" IN SECTION BOX:
4 DEPTH OF COMPLETED WELL: 19 ft. ELEVATION: 1011.34

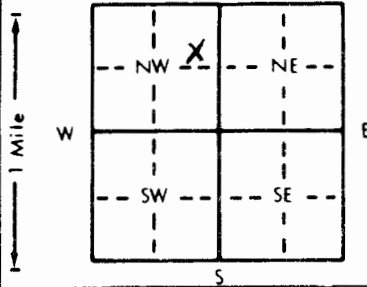

Depth(s) Groundwater Encountered 1. 15.5 ft. 2. . ft. 3. . ft.
WELL'S STATIC WATER LEVEL 16.3 ft. below land surface measured on mo/day/yr 02-20-94
Pump test data: Well water was . ft. after . hours pumping . gpm
Est. Yield . gpm: Well water was . ft. after . hours pumping . gpm
Bore Hole Diameter: 8 in. to . ft. and . in. to . ft.
WELL WATER TO BE USED AS:
5 Public water supply 8 Air conditioning 11 Injection well
1 Domestic 3 Feedlot 6 Oil field water supply 9 Dewatering 12 Other (Specify below)
2 Irrigation 4 Industrial 7 Lawn and garden only 10 Monitoring well
Was a chemical/bacteriological sample submitted to Department? Yes . No .; If yes, mo/day/yr sample was submitted
Water Well Disinfected? Yes No

5 TYPE OF BLANK CASING USED:
1 Steel 3 RMP (SR) 5 Wrought iron 8 Concrete tile CASING JOINTS: Glued . Clamped .
2 PVC 4 ABS 6 Asbestos-Cement 9 Other (specify below) Welded .
7 Fiberglass Threaded. ✓

Blank casing diameter 2 in. to 10 ft., Dia . in. to . ft., Dia . in. to . ft.
Casing height above land surface 59 in., weight . lbs./ft. Wall thickness or gauge No .

TYPE OF SCREEN OR PERFORATION MATERIAL:
1 Steel 3 Stainless steel 5 Fiberglass 8 RMP (SR) 10 Asbestos-cement
2 Brass 4 Galvanized steel 6 Concrete tile 9 ABS 11 Other (specify) .
12 None used (open hole)

SCREEN OR PERFORATION OPENINGS ARE:
1 Continuous slot 3 Mill slot 5 Gauzed wrapped 8 Saw cut 11 None (open hole)
2 Louvered shutter 4 Key punched 6 Wire wrapped 9 Drilled holes
7 Torch cut 10 Other (specify) .

SCREEN-PERFORATED INTERVALS: From 10 ft. to 20 ft., From . ft. to . ft.
From . ft. to . ft., From . ft. to . ft.
GRAVEL PACK INTERVALS: From 8 ft. to 20 ft., From . ft. to . ft.
From . ft. to . ft., From . ft. to . ft.

6 GROUT MATERIAL: 1 Neat cement 2 Cement grout 3 Bentonite 4 Other .
Grout Intervals: From 0 ft. to 8 ft., From . ft. to . ft., From . ft. to . ft.

What is the nearest source of possible contamination:
1 Septic tank 4 Lateral lines 7 Pit privy 8 Fuel storage 10 Livestock pens 14 Abandoned water well
2 Sewer lines 5 Cess pool 8 Sewage lagoon 12 Fertilizer storage 15 Oil well/Gas well
3 Watertight sewer lines 6 Seepage pit 9 Feedyard 13 Insecticide storage 16 Other (specify below)

Direction from well? SW How many feet?

FROM	TO	LITHOLOGIC LOG	FROM	TO	PLUGGING INTERVALS
0.	0.5	Asphalt			
0.5	15	Soft, brown to light gray, fine sand			
15	21	Soft, gray, med. sand			

7 CONTRACTOR'S OR LANDOWNER'S CERTIFICATION: This water well was (1) constructed (2) reconstructed, or (3) plugged under my jurisdiction and was completed on (mo/day/year) 11-23-93 and this record is true to the best of my knowledge and belief. Kansas Water Well Contractor's License No. 529 This Water Well Record was completed on (mo/day/yr) 04-15-94 under the business name of Geotechnology Inc. by (signature) A. Baldwin

OFFICE USE ONLY
T
R
EW
SEC