


1 LOCATION OF WATER WELL: County: Riley Fraction: NE 1/4 SW 1/4 NW 1/4 Section Number: 10 Township Number: T 10 S Range Number: R 8 E

Distance and direction from nearest town or city street address of well if located within city?
1701 Anderson

2 WATER WELL OWNER: Amoco Corporation
RR#, St. Address, Box #: 7201 E. 38th Street, Space 7253
City, State, ZIP Code: Tulsa, Oklahoma 74102
Board of Agriculture, Division of Water Resources
Application Number:

3 LOCATE WELL'S LOCATION WITH AN "X" IN SECTION BOX:
4 DEPTH OF COMPLETED WELL: 30.0 ft. ELEVATION: _____

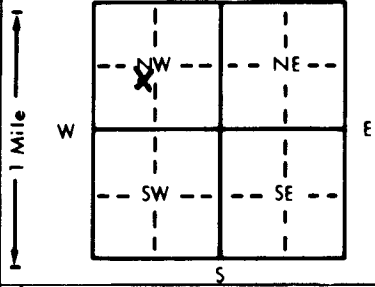

Depth(s) Groundwater Encountered 1. 15.5 ft. 2. _____ ft. 3. _____ ft.
WELL'S STATIC WATER LEVEL 15.5 ft. below land surface measured on mo/day/yr 11/14/88
Pump test data: Well water was _____ ft. after _____ hours pumping _____ gpm
Est. Yield _____ gpm: Well water was _____ ft. after _____ hours pumping _____ gpm
Bore Hole Diameter: 6.0 in. to 30.0 ft., and _____ in. to _____ ft.
WELL WATER TO BE USED AS:
5 Public water supply 8 Air conditioning 11 Injection well
1 Domestic 3 Feedlot 6 Oil field water supply 9 Dewatering 12 Other (Specify below)
2 Irrigation 4 Industrial 7 Lawn and garden only 10 Monitoring well
Was a chemical/bacteriological sample submitted to Department? Yes _____ No X; If yes, mo/day/yr sample was submitted _____
Water Well Disinfected? Yes _____ No X

5 TYPE OF BLANK CASING USED:
1 Steel 3 RMP (SR) 5 Wrought iron 8 Concrete tile CASING JOINTS: Glued _____ Clamped _____
2 PVC 4 ABS 6 Asbestos-Cement 9 Other (specify below) Welded _____
Blank casing diameter 2.0 in. to 10.0 ft., Dia _____ in. to _____ ft., Dia _____ in. to _____ ft.
Casing height above land surface: 0 in., weight _____ lbs./ft. Wall thickness or gauge No. 40

TYPE OF SCREEN OR PERFORATION MATERIAL:
1 Steel 3 Stainless steel 5 Fiberglass 8 RMP (SR) 10 Asbestos-cement
2 Brass 4 Galvanized steel 6 Concrete tile 9 ABS 12 None used (open hole)

SCREEN OR PERFORATION OPENINGS ARE:
1 Continuous slot 3 Mill slot 5 Gauzed wrapped 8 Saw cut 11 None (open hole)
2 Louvered shutter 4 Key punched 6 Wire wrapped 9 Drilled holes
3 Torch cut 10 Other (specify) _____

SCREEN-PERFORATED INTERVALS: From 10.0 ft. to 30.0 ft., From _____ ft. to _____ ft.
GRAVEL PACK INTERVALS: From 8.0 ft. to 30.0 ft., From _____ ft. to _____ ft.

6 GROUT MATERIAL: 1 Neat cement 2 Cement grout 3 Bentonite 4 Other _____
Grout intervals: From _____ ft. to _____ ft., From _____ ft. to _____ ft.

What is the nearest source of possible contamination:
1 Septic tank 4 Lateral lines 7 Pit privy 17 Fuel storage 14 Abandoned water well
2 Sewer lines 5 Cess pool 8 Sewage lagoon 12 Fertilizer storage 15 Oil well/Gas well
3 Watertight sewer lines 6 Seepage pit 9 Feedyard 13 Insecticide storage 16 Other (specify below)

Direction from well? Northeast How many feet? 15

FROM	TO	LITHOLOGIC LOG	FROM	TO	PLUGGING INTERVALS
<u>0.5</u>	<u>0.5</u>	<u>Asphalt</u>			
<u>0.5</u>	<u>7.0</u>	<u>Clay: Black to Brown fair odor</u>			
<u>7.0</u>	<u>14.0</u>	<u>Clay: Dark gray, slight odor</u>			
<u>14.0</u>	<u>30.0</u>	<u>Clay: Brown, slight odor</u>			
		<u>Grout Variance granted 11-7-88 by Darryl Plummer. Casing height variance granted 11-22-88 by Darryl Plummer.</u>			

7 CONTRACTOR'S OR LANDOWNER'S CERTIFICATION: This water well was 1 constructed, (2) reconstructed, or (3) plugged under my jurisdiction and was completed on (mo/day/year) 10-28-88 and this record is true to the best of my knowledge and belief. Kansas Water Well Contractor's License No. 496 This Water Well Record was completed on (mo/day/yr) 11/14/88 under the business name of David Daniels by (signature) [Signature]

OFFICE USE ONLY
T
R
EW
SEC.
1/4
1/4
1/4