


1 LOCATION OF WATER WELL: County: Riley Fraction: NE 1/4 SW 1/4 NW 1/4 Section Number: 18 Township Number: T 10 S Range Number: R 8 E

Distance and direction from nearest town or city street address of well if located within city?  
1701 Anderson

2 WATER WELL OWNER: Amoco Corporation  
 RR#, St. Address, Box #: 7201 E. 38th Street, Space 7253  
 City, State, ZIP Code: Tulsa, Oklahoma 74102  
 Board of Agriculture, Division of Water Resources  
 Application Number:

3 LOCATE WELL'S LOCATION WITH AN "X" IN SECTION BOX:

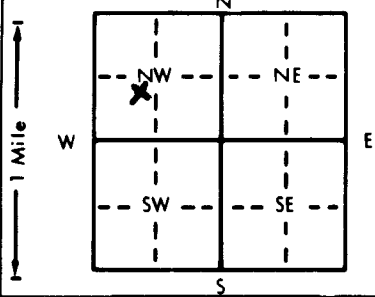

4 DEPTH OF COMPLETED WELL: 30.0 ft. ELEVATION:  
 Depth(s) Groundwater Encountered 1. 17.0 ft. 2. ft. 3. ft.  
 WELL'S STATIC WATER LEVEL: 15.4 ft. below land surface measured on mo/day/yr 11/14/88  
 Pump test data: Well water was ft. after hours pumping gpm  
 Est. Yield gpm: Well water was ft. after hours pumping gpm  
 Bore Hole Diameter: 6.0 in. to 30.0 ft., and in. to ft.  
 WELL WATER TO BE USED AS:  
 5 Public water supply 8 Air conditioning 11 Injection well  
 1 Domestic 3 Feedlot 6 Oil field water supply 9 Dewatering 12 Other (Specify below)  
 2 Irrigation 4 Industrial 7 Lawn and garden only 10 Monitoring well  
 Was a chemical/bacteriological sample submitted to Department? Yes No X; If yes, mo/day/yr sample was submitted  
 Water Well Disinfected? Yes No X

5 TYPE OF BLANK CASING USED:  
 1 Steel 3 RMP (SR) 5 Wrought iron 8 Concrete tile CASING JOINTS: Glued Clamped  
2 PVC 4 ABS 6 Asbestos-Cement 9 Other (specify below) Welded  
 7 Fiberglass Threaded X  
 Blank casing diameter: 2 in. to 30 ft., Dia. in. to ft., Dia. in. to ft.  
 Casing height above land surface: 0 in., weight lbs./ft. Wall thickness or gauge No. 40

TYPE OF SCREEN OR PERFORATION MATERIAL:  
 1 Steel 3 Stainless steel 5 Fiberglass 8 RMP (SR) 10 Asbestos-cement  
 2 Brass 4 Galvanized steel 6 Concrete tile 9 ABS 11 Other (specify)  
 12 None used (open hole)

SCREEN OR PERFORATION OPENINGS ARE:  
 1 Continuous slot 3 Mill slot 5 Gauzed wrapped 8 Saw cut 11 None (open hole)  
 2 Louvered shutter 4 Key punched 6 Wire wrapped 9 Drilled holes  
 7 Torch cut 10 Other (specify)

SCREEN-PERFORATED INTERVALS: From 10 ft. to 30 ft., From ft. to ft.  
 From ft. to ft., From ft. to ft.  
 GRAVEL PACK INTERVALS: From 8 ft. to 30 ft., From ft. to ft.  
 From ft. to ft., From ft. to ft.

6 GROUT MATERIAL: 1 Neat cement 2 Cement grout 3 Bentonite 4 Other  
 Grout intervals: From 0 ft. to 8.0 ft., From ft. to ft., From ft. to ft.

What is the nearest source of possible contamination:  
 1 Septic tank 4 Lateral lines 7 Pit privy 11 Fuel storage 14 Abandoned water well  
 2 Sewer lines 5 Cess pool 8 Sewage lagoon 12 Fertilizer storage 15 Oil well/Gas well  
 3 Watertight sewer lines 6 Seepage pit 9 Feedyard 13 Insecticide storage 16 Other (specify below)  
 Direction from well? South How many feet? 10

FROM	TO	LITHOLOGIC LOG	FROM	TO	PLUGGING INTERVALS
0	0.5	Asphalt			
0.5	6.0	Clay: Black, good odor			
6.0	11.0	Clay: Dark gray, fair odor			
11.0	15.0	Clay: Greenish Gray, fair odor			
15.0	25.0	Clay: Red Brown, slight odor			
		Grout variance granted 11-7-88 by Darryl Plummer.			
		Casing height variance granted 11-22-88 by Darryl Plummer			

7 CONTRACTOR'S OR LANDOWNER'S CERTIFICATION: This water well was 1 constructed, (2) reconstructed, or (3) plugged under my jurisdiction and was completed on (mo/day/year) 10-25-88 and this record is true to the best of my knowledge and belief. Kansas Water Well Contractor's License No. 496 This Water Well Record was completed on (mo/day/yr) 11/14/88 under the business name of David Daniels by (signature) [Signature]

OFFICE USE ONLY  
T  
R  
EW  
SEC.