


1 LOCATION OF WATER WELL: Fraction **NE 1/4 SW 1/4 NW 1/4** Section Number **18** Township Number **T 10 S** Range Number **R 8 E**  
 County: **Riley**

Distance and direction from nearest town or city street address of well if located within city?  
**1701 Anderson**

2 WATER WELL OWNER: **Amoco Corporation**  
 RR#, St. Address, Box #: **7201 E. 38th Street, Space 7253** Board of Agriculture, Division of Water Resources  
 City, State, ZIP Code: **Tulsa, Oklahoma. 74102** Application Number:

3 LOCATE WELL'S LOCATION WITH AN "X" IN SECTION BOX:

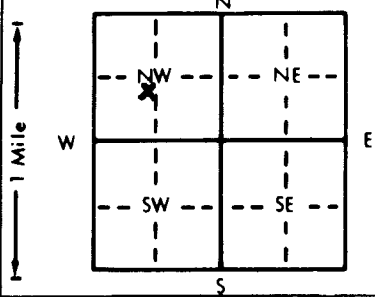

4 DEPTH OF COMPLETED WELL: **25.0** ft. ELEVATION: .....  
 Depth(s) Groundwater Encountered 1. **17.0** ft. 2. .... ft. 3. .... ft.  
 WELL'S STATIC WATER LEVEL: **14.3** ft. below land surface measured on mo/day/yr **11/4/88**  
 Pump test data: Well water was ..... ft. after ..... hours pumping ..... gpm  
 Est. Yield ..... gpm: Well water was ..... ft. after ..... hours pumping ..... gpm  
 Bore Hole Diameter: **6.0** in. to **250** ft., and ..... in. to ..... ft.  
 WELL WATER TO BE USED AS:  
 5 Public water supply 8 Air conditioning 11 Injection well  
 1 Domestic 3 Feedlot 6 Oil field water supply 9 Dewatering 12 Other (Specify below)  
 2 Irrigation 4 Industrial 7 Lawn and garden only  Monitoring well  
 Was a chemical/bacteriological sample submitted to Department? Yes.....No. ; If yes, mo/day/yr sample was submitted  
 Water Well Disinfected? Yes ..... No

5 TYPE OF BLANK CASING USED:  
 1 Steel 3 RMP (SR) 5 Wrought iron 8 Concrete tile CASING JOINTS: Glued ..... Clamped .....  
 PVC 4 ABS 7 Fiberglass 9 Other (specify below) Welded .....  
 Blank casing diameter: **2.0** in. to **10** ft., Dia ..... in. to ..... ft., Dia ..... in. to ..... ft.  
 Casing height above land surface: **0** in., weight ..... lbs./ft. Wall thickness or gauge No. **40**

TYPE OF SCREEN OR PERFORATION MATERIAL:  
 1 Steel 3 Stainless steel 5 Fiberglass 8 RMP (SR) 10 Asbestos-cement  
 2 Brass 4 Galvanized steel 6 Concrete tile 9 ABS 12 None used (open hole)

SCREEN OR PERFORATION OPENINGS ARE:  
 1 Continuous slot  Mill slot 5 Gauzed wrapped 8 Saw cut 11 None (open hole)  
 2 Louvered shutter 4 Key punched 6 Wire wrapped 9 Drilled holes  
 7 Torch cut 10 Other (specify) .....

SCREEN-PERFORATED INTERVALS: From **10.0** ft. to **25.0** ft., From ..... ft. to ..... ft.  
 From ..... ft. to ..... ft., From ..... ft. to ..... ft.  
 GRAVEL PACK INTERVALS: From **8.0** ft. to **25.0** ft., From ..... ft. to ..... ft.  
 From ..... ft. to ..... ft., From ..... ft. to ..... ft.

6 GROUT MATERIAL:  Neat cement 2 Cement grout  Bentonite 4 Other .....  
 Grout Intervals: From **8** ft. to **8.0** ft., From ..... ft. to ..... ft., From ..... ft. to ..... ft.

What is the nearest source of possible contamination:  
 1 Septic tank 4 Lateral lines 7 Pit privy  Livestock pens 14 Abandoned water well  
 2 Sewer lines 5 Cess pool 8 Sewage lagoon  Fuel storage 15 Oil well/Gas well  
 3 Watertight sewer lines 6 Seepage pit 9 Feedyard 12 Fertilizer storage 16 Other (specify below)  
 13 Insecticide storage  
 Direction from well? **Southeast** How many feet? **10**

FROM	TO	LITHOLOGIC LOG	FROM	TO	PLUGGING INTERVALS
0	0.5	Asphalt			
0.5	2.0	Clay: Black, strong gas odor			
2.0	10.0	Clay: Brownish gray, good odor			
10.0	17.0	Clay: Brownish gray with some greenish gray laminations in base, good odor			
17.0	25.0	Clay: Reddish Brown, slight odor			
Grout variance granted 11/7/88 by Darryl Plummer casing height variance granted 11/22/88 by Darryl Plummer.					

7 CONTRACTOR'S OR LANDOWNER'S CERTIFICATION: This water well was  constructed, (2) reconstructed, or (3) plugged under my jurisdiction and was completed on (mo/day/year) **10/25/88** and this record is true to the best of my knowledge and belief. Kansas Water Well Contractor's License No. **496** This Water Well Record was completed on (mo/day/yr) **11/4/88** under the business name of **David Daniels** by (signature) *David Daniels*

OFFICE USE ONLY  
T  
R  
EW  
SEC.  
1/4  
1/4  
1/4