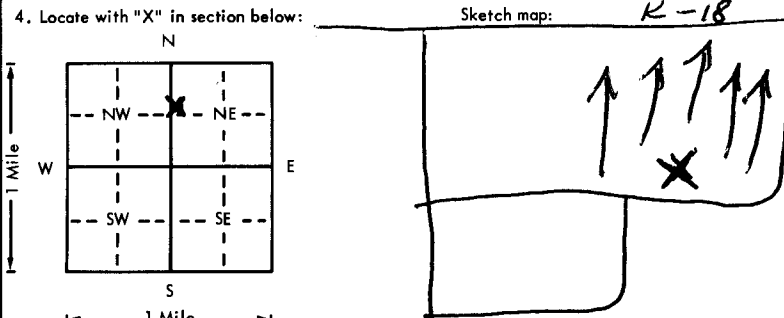


USE TYPEWRITER OR BALL POINT PEN-PRESS FIRMLY, PRINT CLEARLY.

WATER WELL RECORD
KSA 82a-1201-1215

Kansas Department of Health and Environment-Division of Environment (Water well Contractors) Topeka, Kansas 66620

1. Location of well:	County Riley	Fraction SW 1/4 NW 1/4 NE 1/4	Section number 25	Township number T 10 S	Range number R 8 E/W
2. Distance and direction from nearest town or city 6 1/2 miles East of Manhattan, Ks. on K-18 & 1/4 mile south.			3. Owner of well: John G. Holle R.R. or street: R. R. #3 City, state, zip code: Manhattan, Ks. 66502		
4. Locate with "X" in section below: 			6. Bore hole dia. 30 in. Completion date 8-30-77 Well depth 25 ft.		
5. Type and color of material			7. <input type="checkbox"/> Cable tool <input type="checkbox"/> Rotary <input type="checkbox"/> Driven <input type="checkbox"/> Dug <input type="checkbox"/> Hollow rod <input type="checkbox"/> Jetted <input checked="" type="checkbox"/> Bored <input checked="" type="checkbox"/> Reverse rotary		
			8. Use: <input type="checkbox"/> Domestic <input type="checkbox"/> Public supply <input type="checkbox"/> Industry <input checked="" type="checkbox"/> Irrigation <input type="checkbox"/> Air conditioning <input type="checkbox"/> Stock <input type="checkbox"/> Lawn <input type="checkbox"/> Oil field water <input type="checkbox"/> Other		
			9. Casing: Material steel Height: (Above or below) _____ Threaded _____ Welded <input checked="" type="checkbox"/> Surface 12 in. RMP _____ PVC _____ Weight _____ lbs./ft. Dia. 16 in. to 55 ft. depth Wall Thickness: inches or _____ Dia. _____ in. to _____ ft. depth gage No. 029		
			10. Screen: Manufacturer's name Free-Flo W. A. Brown Enterprises Type steel Dia. 16" (S) gauze 1/4x4 Length 20' Set between 55 55 ft. and 75 ft. _____ ft. and _____ ft. Gravel pack? <input checked="" type="checkbox"/> yes Size range of material 1/8-1/4"		
			11. Static water level: _____ mo./day/yr. 15 ft. below land surface Date 6-18-77		
			12. Pumping level below land surfaces: 37 ft. after 1 hrs. pumping 800 g.p.m. 42 ft. after 3 hrs. pumping 800 g.p.m. Estimated maximum yield 1100 g.p.m.		
			13. Water sample submitted: _____ mo./day/yr. <input type="checkbox"/> Yes <input checked="" type="checkbox"/> No Date _____		
			14. Well head completion: <input type="checkbox"/> Pitless adapter _____ Inches above grade		
			15. Well grouted? <input checked="" type="checkbox"/> yes With: <input type="checkbox"/> Neat cement <input type="checkbox"/> Bentonite <input checked="" type="checkbox"/> Concrete Depth: From 0 ft. to 10 ft.		
			16. Nearest source of possible contamination drainage ft. 70 Direction south Type ditch Well disinfected upon completion? <input type="checkbox"/> Yes <input checked="" type="checkbox"/> No		
			17. Pump: <input checked="" type="checkbox"/> Not installed Manufacturer's name _____ Model number _____ HP _____ Volts _____ Length of drop pipe _____ ft. capacity _____ g.p.m. Type: <input type="checkbox"/> Submersible <input type="checkbox"/> Turbine <input type="checkbox"/> Jet <input type="checkbox"/> Reciprocating <input type="checkbox"/> Centrifugal <input type="checkbox"/> Other		
			(Use a second sheet if needed)		
18. Elevation: Topography: <input type="checkbox"/> Hill <input type="checkbox"/> Slope <input type="checkbox"/> Upland <input checked="" type="checkbox"/> Valley		19. Remarks: We do not install pumps. Delay in filing report due to delay in obtaining legal description.			
		20. Water well contractor's certification: This well was drilled under my jurisdiction and this report is true to the best of my knowledge and belief. Hoobler Drilling Co. 323 Business name License No. Address St. Marys, Ks. 66536 Signed [Signature] Date 9-26-77 Authorized representative			

T 10 S 8 W Sec 25 SW 1/4 NE 1/4

Forward the white, blue and pink copies to the Department of Health and Environment

Form WWC-5