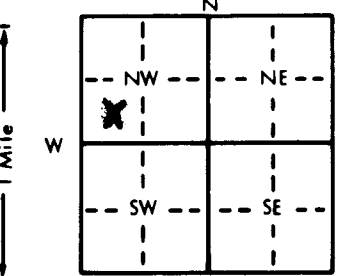


1 LOCATION OF WATER WELL: County: Riley Fraction: Near Center SW 1/4 NW 1/4 Section Number: 25 Township Number: T 10 S Range Number: R 8 E

Distance and direction from nearest town or city street address of well if located within city?
2 mile west of Zeandale Ks. on K-18 to Pleasant Valley Rd. 3/4 mi. S. and 1/4 mi. W.

2 WATER WELL OWNER: Leroy Miller
 RR#, St. Address, Box #: 704 Country Club Circle Board of Agriculture, Division of Water Resources
 City, State, ZIP Code: Wamego, Ks. 66547 Application Number: 28,786

3 LOCATE WELL'S LOCATION WITH AN "X" IN SECTION BOX:


4 DEPTH OF COMPLETED WELL: 80 ft. ELEVATION: _____
 Depth(s) Groundwater Encountered 1. 31 ft. 2. _____ ft. 3. _____ ft.
 WELL'S STATIC WATER LEVEL 31 ft. below land surface measured on mo/day/yr 11-16-90
 Pump test data: Well water was 47 ft. after 1 hours pumping 1200 gpm
 Est. Yield 1500 gpm: Well water was 52 ft. after 2 hours pumping 1200 gpm
 Bore Hole Diameter _____ in. to _____ ft., and _____ in. to _____ ft.
 WELL WATER TO BE USED AS:
 5 Public water supply 8 Air conditioning 11 Injection well
 1 Domestic 3 Feedlot 6 Oil field water supply 9 Dewatering 12 Other (Specify below)
 2 Irrigation 4 Industrial 7 Lawn and garden only 10 Monitoring well
 Was a chemical/bacteriological sample submitted to Department? Yes _____ No xx; If yes, mo/day/yr sample was submitted _____
 Water Well Disinfected? Yes _____ No xx

5 TYPE OF BLANK CASING USED:
 1 Steel 3 RMP (SR) 5 Wrought iron 8 Concrete tile CASING JOINTS: Glued _____ Clamped xx
 -2 PVC 4 ABS 6 Asbestos-Cement 9 Other (specify below) Welded _____
 7 Fiberglass _____ Threaded _____
 Blank casing diameter 12 in. to 40 ft., Dia _____ in. to _____ ft., Dia _____ in. to _____ ft.
 Casing height above land surface 12 in., weight _____ lbs./ft. Wall thickness or gauge No. 65
 TYPE OF SCREEN OR PERFORATION MATERIAL:
 1 Steel 3 Stainless steel 5 Fiberglass 7 PVC 10 Asbestos-cement
 2 Brass 4 Galvanized steel 6 Concrete tile 8 RMP (SR) 11 Other (specify) _____
 9 ABS 12 None used (open hole)
 SCREEN OR PERFORATION OPENINGS ARE:
 1 Continuous slot 3 Mill slot 5 Gauzed wrapped 8 Saw cut 11 None (open hole)
 2 Louvered shutter 4 Key punched 6 Wire wrapped 9 Drilled holes
 7 Torch cut 10 Other (specify) _____
 SCREEN-PERFORATED INTERVALS: From 40 ft. to 80 ft., From _____ ft. to _____ ft.
 From _____ ft. to _____ ft., From _____ ft. to _____ ft.
 GRAVEL PACK INTERVALS: From 20 ft. to 80 ft., From _____ ft. to _____ ft.
 From _____ ft. to _____ ft., From _____ ft. to _____ ft.

6 GROUT MATERIAL: 1 Neat cement 2 Cement grout 3 Bentonite 4 Other _____
 Grout Intervals: From 0 ft. to 20 ft., From _____ ft. to _____ ft., From _____ ft. to _____ ft.
 What is the nearest source of possible contamination:
 1 Septic tank 4 Lateral lines 7 Pit privy 10 Livestock pens 14 Abandoned water well
 2 Sewer lines 5 Cess pool 8 Sewage lagoon 11 Fuel storage 15 Oil well/Gas well
 3 Watertight sewer lines 6 Seepage pit 9 Feedyard 12 Fertilizer storage 16 Other (specify below)
 13 Insecticide storage NONE

Direction from well? _____ How many feet? _____

FROM	TO	LITHOLOGIC LOG	FROM	TO	PLUGGING INTERVALS
0	6	Heavy black silt			
6	44	Grey and brown clays			
44	51	Fine grey sand and grey clay			
51	53	Medium-large grey gravel and grey clays			
53	55	Small-medium grey gravel and grey clays			
55	61	Small-medium grey gravel			
61	80	Medium-large grey gravel			
80		Weathered shale, stopped			

7 CONTRACTOR'S OR LANDOWNER'S CERTIFICATION: This water well was (1) constructed, (2) reconstructed, or (3) plugged under my jurisdiction and was completed on (mo/day/year) 11-15-90 and this record is true to the best of my knowledge and belief. Kansas Water Well Contractor's License No. 323 This Water Well Record was completed on (mo/day/yr) 11-28-90 under the business name of Hoobler Drilling Co. by (signature) [Signature]

OFFICE USE ONLY