

County: Riley Fraction SE SE SW NE Sec. 29 T 10 S R 8 (E)W

CORRECTION(S) TO WATER WELL COMPLETION RECORD (WWC-5)

(to rectify lacking or incorrect information)

Owner: Buck Gehrt - Roger Luthi

Location was listed as:

Section-Township-Range: 29-10S-8E

Fraction ($\frac{1}{4}$ $\frac{1}{4}$ $\frac{1}{4}$): SW SW NE

Location changed to:

29-10S-8E

SE SE SW NE

Other changes: Initial statements: Buck Garrett

Changed to: Buck Gehrt

Comments: Address: 210 Gehrt Rd.

Verification method: E-mail communication from current landowner
(Elizabeth Stevens), area road map, and mapping tool & aerial
photos on KGS website. initials: ARL date: 12/26/2012

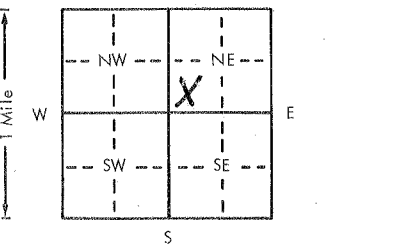
Submitted by: Kansas Geological Survey, Data Resources Library, 1930 Constant Ave., Lawrence, KS 66047-3726

to: Kansas Dept of Health & Environment, Bureau of Water, 1000 SW Jackson, Suite 420, Topeka, KS 66612-1367.

USE TYPEWRITER OR BALL
POINT PEN-PRESS FIRMLY,
PRINT CLEARLY.

WATER WELL RECORD
KSA 82a-1201-1215

Kansas Department of Health and
Environment-Division of Environment
(Water well Contractors)
Topeka, Kansas 66620

1. Location of well: County: <u>Riley</u> Fraction: <u>SW 1/4 SW 1/4 NE 1/4</u> Section number: <u>29</u> Township number: <u>T 10</u> Range number: <u>R 8</u> Elev: <u>EW</u>	
2. Distance and direction from nearest town or city: <u>1 S of</u> Street address of well location if in city: <u>MANHATTAN</u>	
3. Owner of well: <u>BUCK GARRETT-ROGER LUTHE</u> R.R. or street: <u>3112 E 114 LN</u> City, state, zip code: <u>MANHATTAN, KS. 66502</u>	
4. Locate with "X" in section below: N NW NE SW SE S 1 Mile Sketch map: 	
5. Type and color of material	
shale, yellow, grey, red	
shale, lime, grey	
shale, yellow, red	
Limestone, tan	
Limestone, yellow, water bearing	
shale, grey, red, blk	
Limestone, brown, water bearing	
shale, lime grey, shale, grey	
(Use a second sheet if needed)	
18. Elevation:	
19. Remarks: <u>OWNER TO INSTALL SLAB</u>	
6. Bore hole dia. <u>8</u> in. Completion date <u>5-15-79</u> Well depth <u>300</u> ft.	
7. ☒ Cable tool ☐ Rotary ☐ Driven ☐ Dug ☐ Hollow rod ☐ Jetted ☐ Bored ☐ Reverse rotary	
8. Use: ☒ Domestic ☐ Public supply ☐ Industry ☐ Irrigation ☐ Air conditioning ☐ Stock ☐ Lawn ☐ Oil field water ☐ Other	
9. Casing: Material <u>PVC</u> Height: <u>Above</u> or below Threaded ☐ Welded ☐ Surface <u>29</u> in. RMP ☐ PVC <u>9L</u> Weight <u>2.82</u> lbs./ft. Dia. <u>5</u> in. to <u>200</u> ft. depth Wall Thickness: inches or Dia. <u>5</u> in. to <u>200</u> ft. depth gauge No. <u>1258</u>	
10. Screen: Manufacturer's name <u>PUMPCO MBI</u> Type <u>PVC</u> Dia. <u>5</u> Slot/gauge <u>1060</u> Length <u>100</u> Set between <u>100</u> ft. and <u>200</u> ft. Gravel pack? ☒ Size range of material <u>1/4 x 1/8</u>	
11. Static water level: <u>198</u> ft. below land surface Date <u>5-15-79</u> mo./day/yr.	
12. Pumping level below land surfaces: ft. after hrs. pumping g.p.m. ft. after hrs. pumping g.p.m. Estimated maximum yield <u>2</u> g.p.m.	
13. Water sample submitted: <u>Yes</u> ☒ No ☐ Date <u>5-15-79</u> mo./day/yr.	
14. Well head completion: <u>CAP</u> Pitless adapter <u>24</u> inches above grade	
15. Well grouted? ☒ With: ☒ Neat cement ☐ Bentonite ☐ Concrete Depth: From <u>0</u> ft. to <u>10</u> ft.	
16. Nearest source of possible contamination: ft. <u>100</u> Direction <u>N</u> Type <u>SEPTIC</u> Well disinfected upon completion? ☒ Yes ☐ No	
17. Pump: ☒ Not installed Manufacturer's name _____ Model number _____ HP _____ Volts _____ Length of drop pipe _____ ft. capacity _____ g.p.m. Type: _____ ☐ Submersible ☐ Turbine ☐ Jet ☐ Reciprocating ☐ Centrifugal ☐ Other	
20. Water well contractor's certification: This well was drilled under my jurisdiction and this report is true to the best of my knowledge and belief. <u>STRADER Dalg G Inc 1/82</u> Business name _____ License No. _____ Address <u>RT 1 Holton, KS</u> Signed <u>Dale Asken</u> Date <u>5-16-79</u> Authorized representative	

Forward the white, blue and pink copies to the Department of Health and Environment

Form WWC-5