


1 LOCATION OF WATER WELL:	Fraction	Section Number	Township Number	Range Number
County: Pottawatomie	NE 1/4 SE 1/4 SW 1/4	8	T 10 S	R 8 E 11

Distance and direction from nearest town or city street address of well if located within city?  
 Approximately 500' north of McCall and 846' west of Kretschner Drive, Manhattan

2 WATER WELL OWNER: Manhattan, City of  
 RR#, St. Address, Box # : City Hall - 1101 Poyntz Ave.  
 City, State, ZIP Code : Manhattan, KS 66502  
 Board of Agriculture, Division of Water Resources  
 Application Number: VR PT021

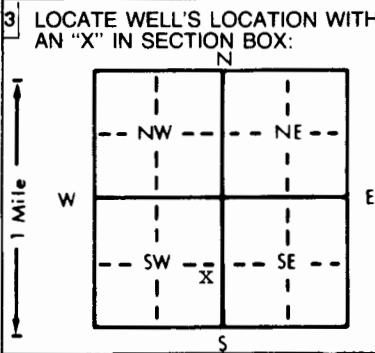

4 DEPTH OF COMPLETED WELL: 68 ft. ELEVATION: unknown  
 Depth(s) Groundwater Encountered 1. . . . . ft. 2. . . . . ft. 3. . . . . ft.  
 WELL'S STATIC WATER LEVEL: 20 ft. below land surface measured on mo/day/yr 11-28-94  
 Pump test data: Well water was not ch'd ft. after . . . . . hours pumping . . . . . gpm  
 Est. Yield unknown gpm: Well water was . . . . . ft. after . . . . . hours pumping . . . . . gpm  
 Bore Hole Diameter: 48 in. to 67 ft., and . . . . . in. to . . . . . ft.  
 WELL WATER TO BE USED AS:  
 1 Domestic 3 Feedlot 6 Oil field water supply 9 Dewatering 12 Other (Specify below)  
 2 Irrigation 4 Industrial 7 Lawn and garden only 10 Monitoring well . . . . .  
 Was a chemical/bacteriological sample submitted to Department? Yes . . . . . No  . . . . .; If yes, mo/day/yr sample was sub-  
 mitted Water Well Disinfected? Yes  No

5 TYPE OF BLANK CASING USED:  
 1 Steel 3 RMP (SR) 5 Wrought iron 8 Concrete tile CASING JOINTS: Glued . . . . . Clamped . . . . .  
 2 PVC 4 ABS 6 Asbestos-Cement 9 Other (specify below) Welded  . . . . .  
 7 Fiberglass Threaded . . . . .  
 Blank casing diameter 24 in. to 42 ft., Dia . . . . . in. to . . . . . ft., Dia . . . . . in. to . . . . . ft.  
 Casing height above land surface 12 in., weight 94.62 lbs./ft. Wall thickness or gauge No. 375  
 TYPE OF SCREEN OR PERFORATION MATERIAL:  
 1 Steel 3 Stainless steel 5 Fiberglass 8 RMP (SR) 10 Asbestos-cement 11 Other (specify) . . . . .  
 2 Brass 4 Galvanized steel 6 Concrete tile 9 ABS 12 None used (open hole)  
 SCREEN OR PERFORATION OPENINGS ARE:  
 1 Continuous slot 3 Mill slot 5 Gauzed wrapped 8 Saw cut 11 None (open hole)  
 2 Louvered shutter 4 Key punched 6 Wire wrapped 9 Drilled holes  
 7 Torch cut 10 Other (specify) . . . . .  
 SCREEN-PERFORATED INTERVALS: From 42 ft. to 67 ft., From . . . . . ft. to . . . . . ft.  
 From . . . . . ft. to . . . . . ft., From . . . . . ft. to . . . . . ft.  
 GRAVEL PACK INTERVALS: From 20 ft. to 67 ft., From . . . . . ft. to . . . . . ft.  
 From . . . . . ft. to . . . . . ft., From . . . . . ft. to . . . . . ft.

6 GROUT MATERIAL: 1 Neat cement 2 Cement grout 3 Bentonite 4 Other .. Bentonite Holeplug . . . . .  
 Grout Intervals: From 0 ft. to 17 ft., From . . . . . ft. to . . . . . ft., From 17 ft. to 20 ft.  
 What is the nearest source of possible contamination:  
 1 Septic tank 4 Lateral lines 7 Pit privy 11 Fuel storage 14 Abandoned water well  
 2 Sewer lines 5 Cess pool 8 Sewage lagoon 12 Fertilizer storage 15 Oil well/Gas well  
 3 Watertight sewer lines 6 Seepage pit 9 Feedyard 13 Insecticide storage . . . . . None known . . . . .

Direction from well? How many feet?

FROM	TO	LITHOLOGIC LOG	FROM	TO	PLUGGING INTERVALS
0	2	Topsoil			
2	16	Clay, silty			
16	19	Clay with sand and gravel			
19	28	Sand and gravel, fine, medium			
28	30	Clay, gray			
30	50	Sand and gravel, fine, medium			
50	67	Sand and gravel, fine, medium, coarse with 2" and 3" rocks			

7 CONTRACTOR'S OR LANDOWNER'S CERTIFICATION: This water well was (1) constructed, (2) reconstructed, or (3) plugged under my jurisdiction and was completed on (mo/day/year) ~~XXXXXXXXXX~~ 12-28-94 . . . . . and this record is true to the best of my knowledge and belief. Kansas Water Well Contractor's License No. 185 . . . . . This Water Well Record was completed on (mo/day/yr) ~~XXXXXXXXXX~~ 12-28-95 . . . . . under the business name of Clarke Well & Equipment, Inc. by (signature) *Clarke Well & Equipment, Inc.*