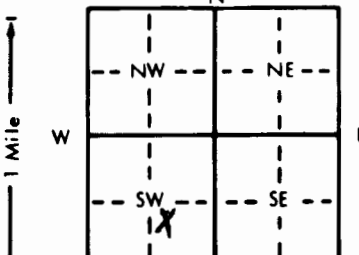


1 LOCATION OF WATER WELL: County: Riley 081 Fraction: NW 1/4 SE 1/4 SW 1/4 Section Number: 17 Township Number: T 10 S Range Number: R 8 E  
 Distance and direction from nearest town or city street address of well if located within city? Manhattan 361 Klubin Fairmont Addition

2 WATER WELL OWNER: Riley Co Public Works  
 RR#, St. Address, Box #: COURT HOUSE PLAZA Board of Agriculture, Division of Water Resources  
 City, State, ZIP Code: Manhattan, KS 66502 Application Number:

3 LOCATE WELL'S LOCATION WITH AN "X" IN SECTION BOX:  DEPTH OF COMPLETED WELL: WAS 35 ft. ELEVATION: .....  
 Depth(s) Groundwater Encountered: WAS 13 ft. 2. .... ft. 3. .... ft.  
 WELL'S STATIC WATER LEVEL: WAS 13 ft. below land surface measured on mo/day/yr .....  
 Pump test data: Well water was ..... ft. after ..... hours pumping ..... gpm  
 Est. Yield: 2.0 gpm; Well water was ..... ft. after ..... hours pumping ..... gpm  
 Bore Hole Diameter: ? in. to ..... ft., and ..... in. to ..... ft.  
 WELL WATER TO BE USED AS:  
 1 Domestic  3 Feedlot  6 Oil field water supply  9 Dewatering  12 Other (Specify below)  
 2 Irrigation  4 Industrial  7 Lawn and garden only  10 Monitoring well  
 Was a chemical/bacteriological sample submitted to Department? Yes ..... No ..... If yes, mo/day/yr sample was submitted .....  
 Water Well Disinfected:  Yes  No

5 TYPE OF BLANK CASING USED:  
 1 Steel  3 RMP (SR)  6 Asbestos-Cement  9 Other (specify below)  Welded  
 WAS 2 PVC  4 ABS  7 Fiberglass  Threaded  
 Blank casing diameter: WAS 5 in. to ..... ft. Dia. to ..... ft. Dia. to ..... in. to ..... ft.  
 Casing height above land surface: Cut off 3' below ground lbs./ft. Wall thickness or gauge No. ....  
 TYPE OF SCREEN OR PERFORATION MATERIAL:  
 1 Steel  3 Stainless steel  5 Fiberglass  8 RMP (SR)  10 Asbestos-cement  
 2 Brass  4 Galvanized steel  6 Concrete tile  9 ABS  12 None used (open hole)  
 SCREEN OR PERFORATION OPENINGS ARE:  
 1 Continuous slot  3 Mill slot  6 Wire wrapped  9 Drilled holes  
 2 Louvered shutter  4 Key punched  7 Torch cut  10 Other (specify) .....  
 SCREEN-PERFORATED INTERVALS: From ..... ft. to ..... ft., From ..... ft. to ..... ft.  
 GRAVEL PACK INTERVALS: From 13 ft. to 35 ft., From ..... ft. to ..... ft.

6 GROUT MATERIAL:  1 Neat cement  2 Cement grout  3 Bentonite  4 Other .....  
 Grout intervals: From 3 ft. to 13 ft., From ..... ft. to ..... ft., From ..... ft. to ..... ft.  
 What is the nearest source of possible contamination: Plugged Pit privy  
 1 Septic tank  4 Lateral lines  10 Livestock pens  14 Abandoned water well  
 2 Sewer lines  5 Cess pool  8 Sewage lagoon  11 Fuel storage  15 Oil well/Gas well  
 3 Watertight sewer lines  6 Seepage pit  9 Feedyard  12 Fertilizer storage  16 Other (specify below)  
 13 Insecticide storage  
 Direction from well? How many feet?

FROM	TO	LITHOLOGIC LOG	FROM	TO	PLUGGING INTERVALS
0	3	Compacted clay			
3	13	Bentonite			
13	35	Cloniated sand & gravel			
Plugged					

7 CONTRACTOR'S OR LANDOWNER'S CERTIFICATION: This water well was (1) constructed, (2) reconstructed, or  (3) plugged under my jurisdiction and was completed on (mo/day/year) 12/17/95 and this record is true to the best of my knowledge and belief. Kansas Water Well Contractor's License No. 451 This Water Well Record was completed on (mo/day/year) 2/5/95 under the business name of Holdman Well Drilling by (signature) [Signature]

OFFICE USE ONLY  
T  
R  
EW  
SEC.