


1 LOCATION OF WATER WELL: Fraction SE 1/4 NE 1/4 NE 1/4 Section Number 18 Township Number T 10 S Range Number R 8 E/W  
 County: RILEY

Distance and direction from nearest town or city street address of well if located within city?  
308 BLUEMONT AVE, MANHATTAN, KS

2 WATER WELL OWNER: TOWN & COUNTRY MARKETS  
 RR#, St. Address, Box #: P.O. BOX 17087  
 City, State, ZIP Code: WICHITA, KS 67211  
 Board of Agriculture, Division of Water Resources  
 Application Number:

3 LOCATE WELL'S LOCATION WITH AN "X" IN SECTION BOX:  
 4 DEPTH OF COMPLETED WELL: 25 ft. ELEVATION: 19 ft.

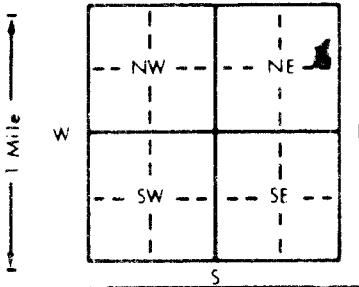

Depth(s) Groundwater Encountered 1. 19 ft. 2. 19 ft. 3. 19 ft.  
 WELL'S STATIC WATER LEVEL 19 ft. below land surface measured on mo/day/yr 3-3-95  
 Pump test data. Well water was \_\_\_\_\_ ft after \_\_\_\_\_ hours pumping \_\_\_\_\_ gpm  
 Est. Yield \_\_\_\_\_ gpm: Well water was \_\_\_\_\_ ft after \_\_\_\_\_ hours pumping \_\_\_\_\_ gpm  
 Bore Hole Diameter 8 in. to 25 ft. and \_\_\_\_\_ in. to \_\_\_\_\_ ft.  
 WELL WATER TO BE USED AS:  
 5 Public water supply 8 Air conditioning 11 Injection well  
 1 Domestic 3 Feedlot 6 Oil field water supply 9 Dewatering 12 Other (Specify below)  
 2 Irrigation 4 Industrial 7 Lawn and garden only 10 Monitoring well  
 Was a chemical/bacteriological sample submitted to Department? Yes No If yes, mo/day/yr sample was submitted \_\_\_\_\_  
 Water Well Disinfected? Yes No

5 TYPE OF BLANK CASING USED:  
 1 Steel 3 RMP (SR) 5 Wrought iron 8 Concrete tile CASING JOINTS: Glued \_\_\_\_\_ Clamped \_\_\_\_\_  
2 PVC 4 ABS 7 Fiberglass \_\_\_\_\_ Welded \_\_\_\_\_  
 Blank casing diameter 2 in. to 10 ft. Dia \_\_\_\_\_ in. to \_\_\_\_\_ ft. Dia \_\_\_\_\_ in. to \_\_\_\_\_ ft.  
 Casing height above land surface 0 in. weight \_\_\_\_\_ lbs./ft. Wall thickness or gauge No \_\_\_\_\_

TYPE OF SCREEN OR PERFORATION MATERIAL:  
 1 Steel 3 Stainless steel 5 Fiberglass 7 PVC 10 Asbestos-cement  
 2 Brass 4 Galvanized steel 6 Concrete tile 9 ABS 12 None used (open hole)  
 8 RMP (SR) 11 Other (specify) \_\_\_\_\_

SCREEN OR PERFORATION OPENINGS ARE:  
 1 Continuous slot 3 Mill slot 5 Gauzed wrapped 8 Saw cut 11 None (open hole)  
 2 Louvered shutter 4 Key punched 6 Wire wrapped 9 Drilled holes  
 7 Torch cut 10 Other (specify) 0.10

SCREEN-PERFORATED INTERVALS: From 25 ft. to 10 ft. From \_\_\_\_\_ ft. to \_\_\_\_\_ ft.  
 From \_\_\_\_\_ ft. to \_\_\_\_\_ ft. From \_\_\_\_\_ ft. to \_\_\_\_\_ ft.  
 GRAVEL PACK INTERVALS: From 25 ft. to 8 ft. From \_\_\_\_\_ ft. to \_\_\_\_\_ ft.  
 From \_\_\_\_\_ ft. to \_\_\_\_\_ ft. From \_\_\_\_\_ ft. to \_\_\_\_\_ ft.

6 GROUT MATERIAL: 1 Neat cement 2 Cement grout 3 Bentonite 4 Other \_\_\_\_\_  
 Grout Intervals: From 8 ft. to 6 ft. From \_\_\_\_\_ ft. to \_\_\_\_\_ ft. From \_\_\_\_\_ ft. to \_\_\_\_\_ ft.

What is the nearest source of possible contamination:  
 1 Septic tank 4 Lateral lines 7 Pit privy 11 Fuel storage 14 Abandoned water well  
 2 Sewer lines 5 Cess pool 8 Sewage lagoon 12 Fertilizer storage 16 Other (specify below)  
 3 Watertight sewer lines 6 Seepage pit 9 Feedyard 13 Insecticide storage

Direction from well? North-East How many feet? 100.0'

FROM	TO	LITHOLOGIC LOG	FROM	TO	PLUGGING INTERVALS
0	3	BRN CLAY SAND			
3	13	LT. BRN SAND SILT			
13	25	TAN SAND			

7 CONTRACTOR'S OR LANDOWNER'S CERTIFICATION: This water well was 1 constructed, (2) reconstructed, or (3) plugged under my jurisdiction and was completed on (mo/day/year) 3-3-95 and this record is true to the best of my knowledge and belief. Kansas Water Well Contractor's License No 568 This Water Well Record was completed on (mo/day/yr) 3-3-95 under the business name of MAX'S ENTERPRISES by (signature) David H. ...

OFFICE USE ONLY  
 T  
 R  
 EW  
 SEC.