


1 LOCATION OF WATER WELL: Fraction SW 1/4 SW 1/4 NE 1/4 Section Number 01 Township Number T 10 S Range Number R 09 E/W  
 County: Pottawatomie

Distance and direction from nearest town or city street address of well if located within city?  
 2.2 miles west of west city limits of Wamego, Kansas

2 WATER WELL OWNER: Kansas Department of Transportation  
 RR#, St. Address, Box # : Docking State Office Building, Topeka, KS. Board of Agriculture, Division of Water Resources  
 City, State, ZIP Code : Application Number: None

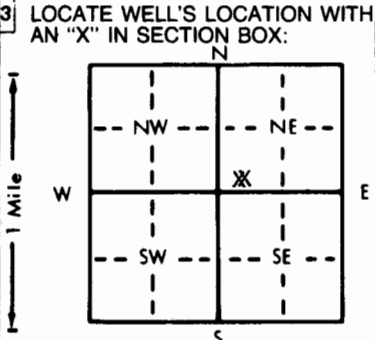

4 DEPTH OF COMPLETED WELL: 79' ft. ELEVATION: unknown  
 Depth(s) Groundwater Encountered 1. 43' ft. 2. ft. 3. ft.  
 WELL'S STATIC WATER LEVEL: 43' ft. below land surface measured on mo/day/yr 7/25/95  
 Pump test data: Well water was na ft. after hours pumping gpm  
 Est. Yield gpm: Well water was ft. after hours pumping gpm  
 Bore Hole Diameter 7.25 in. to at surface ft., and in. to ft.  
 WELL WATER TO BE USED AS:  
 1 Domestic 3 Feedlot 6 Oil field water supply 9 Dewatering 12 Other (Specify below)  
 2 Irrigation 4 Industrial 7 Lawn and garden only 10 Monitoring well  
 Was a chemical/bacteriological sample submitted to Department? Yes.....No.....; If yes, mo/day/yr sample was submitted not known  
 Water Well Disinfected? Yes No

5 TYPE OF BLANK CASING USED:  
 1 Steel 3 RMP (SR) 5 Wrought iron 8 Concrete tile CASING JOINTS: Glued Clamped  
 2 PVC 4 ABS 6 Asbestos-Cement 9 Other (specify below) Welded  
 7 Fiberglass Threaded  
 Blank casing diameter 7.25 in. to ft., Dia in. to ft., Dia in. to ft.  
 Casing height above land surface 2' in., weight lbs./ft. Wall thickness or gauge No. 1/8"  
 TYPE OF SCREEN OR PERFORATION MATERIAL: not known 7 PVC 10 Asbestos-cement  
 1 Steel 3 Stainless steel 5 Fiberglass 8 RMP (SR) 11 Other (specify) NA  
 2 Brass 4 Galvanized steel 6 Concrete tile 9 ABS 12 None used (open hole)  
 SCREEN OR PERFORATION OPENINGS ARE: not known 5 Gauzed wrapped 8 Saw cut 11 None (open hole)  
 1 Continuous slot 3 Mill slot 6 Wire wrapped 9 Drilled holes  
 2 Louvered shutter 4 Key punched 7 Torch cut 10 Other (specify) NA  
 SCREEN-PERFORATED INTERVALS: From not known ft. to NA ft., From ft. to ft.  
 GRAVEL PACK INTERVALS: From ft. to ft., From ft. to ft.

6 GROUT MATERIAL: 1 Neat cement 2 Cement grout 3 Bentonite 4 Other not known  
 Grout Intervals: From 38 ft. to 28 ft., From 15 ft. to 10 ft., From ft. to ft.  
 What is the nearest source of possible contamination: 1 10 Livestock pens 14 Abandoned water well  
 1 Septic tank 4 Lateral lines 7 Pit privy 11 Fuel storage 15 Oil well/Gas well  
 2 Sewer lines 5 Cess pool 8 Sewage lagoon 12 Fertilizer storage 16 Other (specify below)  
 3 Watertight sewer lines 6 Seepage pit 9 Feedyard 13 Insecticide storage  
 Direction from well? East How many feet? 400 yards +/-

FROM	TO	LITHOLOGIC LOG	FROM	TO	PLUGGING INTERVALS
		Not Known	+2'	10'	Chlorinated Sand
			10'	15'	Bentonite
			15'	28'	Chlorinated Sand
			28'	38'	Bentonite
			38'	79'	Chlorinated Sand

7 CONTRACTOR'S OR LANDOWNER'S CERTIFICATION: This water well was (1) constructed, (2) reconstructed, or (3) plugged under my jurisdiction and was completed on (mo/day/year) 3; 7/25/95 and this record is true to the best of my knowledge and belief. Kansas Water Well Contractor's License No. NA This Water Well Record was completed on (mo/day/yr) 7/31/95 under the business name of Kansas Department of Transportation by (signature) Kevin E. Adams

Kevin E. Adams

OFFICE USE ONLY  
T  
R  
EW  
SEC.  
1/4  
1/4  
1/4