


LOCATION OF WATER WELL: Fraction NW 1/4 NW 1/4 SE 1/4 Section Number 07 Township Number T 10 S Range Number R 9 E

Distance and direction from nearest town or city street address of well if located within city?
1 and 3/4 miles West of St. George Kansas

WATER WELL OWNER: Gerald D & Delores A Hargadine
 RR#, St. Address, Box #: 11230 Military Trail Rd
 City, State, ZIP Code: St. George, Kansas, 66535
 Board of Agriculture, Division of Water Resources
 Application Number:

LOCATE WELL'S LOCATION WITH AN "X" IN SECTION BOX: DEPTH OF COMPLETED WELL: 38.8 ft. ELEVATION: 1037±

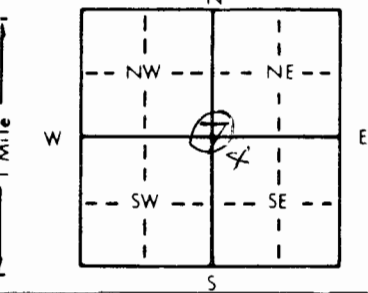

Depth(s) Groundwater Encountered 1. 28.9 ft. 2. _____ ft. 3. _____ ft.
 WELL'S STATIC WATER LEVEL 28.9 ft. below land surface measured on mo/day/yr
 Pump test data: Well water was 30.56 ft. after 24 hours pumping 8 gpm
 Est. Yield 1.7 gpm: Well water was 36.95 ft. after 3/4 hours pumping 1.7 gpm
 Bore Hole Diameter 10 in. to 38.8 ft., and _____ in. to _____ ft.
 WELL WATER TO BE USED AS:
 1 Domestic 3 Feedlot 6 Oil field water supply 9 Dewatering 12 Other (Specify below)
 2 Irrigation 4 Industrial 7 Lawn and garden only 10 Monitoring well
 Was a chemical/bacteriological sample submitted to Department? Yes _____ No _____; If yes, mo/day/yr sample was submitted _____
 Water Well Disinfected? Yes No

TYPE OF BLANK CASING USED:
 1 Steel 3 RMP (SR) 6 Asbestos-Cement 9 Other (specify below)
 2 PVC 4 ABS 7 Fiberglass
 Blank casing diameter 5 in. to 28.8 ft., Dia _____ in. to _____ ft., Dia _____ in. to _____ ft.
 Casing height above land surface 20 in., weight _____ lbs./ft. Wall thickness or gauge No. Schedule 40

TYPE OF SCREEN OR PERFORATION MATERIAL: 7 PVC 10 Asbestos-cement
 1 Steel 3 Stainless steel 5 Fiberglass 8 RMP (SR) 11 Other (specify) _____
 2 Brass 4 Galvanized steel 6 Concrete tile 9 ABS 12 None used (open hole)

SCREEN OR PERFORATION OPENINGS ARE:
 1 Continuous slot 3 Mill slot .025 5 Gauzed wrapped 8 Saw cut 11 None (open hole)
 2 Louvered shutter 4 Key punched 6 Wire wrapped 9 Drilled holes
 7 Torch cut 10 Other (specify) _____

SCREEN-PERFORATED INTERVALS: From 38.8 ft. to 28.8 ft., From _____ ft. to _____ ft.
 From _____ ft. to _____ ft., From _____ ft. to _____ ft.
 GRAVEL PACK INTERVALS: From 38.8 ft. to 20 ft., From _____ ft. to _____ ft.
 From _____ ft. to _____ ft., From _____ ft. to _____ ft.

GROUT MATERIAL: 1 Neat cement 2 Cement grout 3 Bentonite 4 Other _____
 Grout Intervals: From 20 ft. to 4 ft., From _____ ft. to _____ ft., From _____ ft. to _____ ft.

What is the nearest source of possible contamination: Note Bentonite to Surface after Pitless adapter is installed
 1 Septic tank 4 Lateral lines 7 Pit privy 10 Livestock pens 14 Abandoned water well
 2 Sewer lines 5 Cess pool 8 Sewage lagoon 12 Fertilizer storage 16 Other (specify below)
 3 Watertight sewer lines 6 Seepage pit 9 Feedyard 13 Insecticide storage 15 Oil well/Gas well
 Direction from well? How many feet? 1/8 mile North

FROM	TO	LITHOLOGIC LOG	FROM	TO	PLUGGING INTERVALS
0	5	Soil, dark brown, Silty & Sandy			
5	9	Silt, tan, clayey			
9	14	Sand, tan, fine			
14	23	Clay, tan & gray, silty			
23	34.5	Sand, orange, coarse, clean			
34.5	38.8	Shale, gray, silty			

CONTRACTOR'S OR LANDOWNER'S CERTIFICATION: This water well was (1) constructed, (2) reconstructed, or (3) plugged under my jurisdiction and was completed on (mo/day/year) 11-11-96 and this record is true to the best of my knowledge and belief. Kansas Water Well Contractor's License No. _____ This Water Well Record was completed on (mo/day/yr) 11-24-96 under the business name of _____ by (signature) Gerald D Hargadine