


1 LOCATION OF WATER WELL: Fraction Section Number Township Number Range Number
 County: POTTAWATOMIE NE 1/4 NE 1/4 SE 1/4 4 T 10 S R 9E E/W
 Distance and direction from nearest town or city street address of well if located within city?

2 WATER WELL OWNER: Mark Ebert
 RR#, St. Address, Box # : 6240 Salzer Board of Agriculture, Division of Water Resources
 City, State, ZIP Code : Wamego, KS 66547 Application Number:

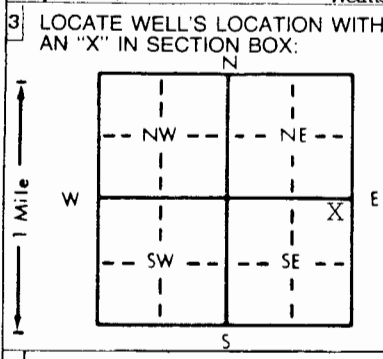

4 DEPTH OF COMPLETED WELL... 156' ft. ELEVATION:
 Depth(s) Groundwater Encountered 1. ft. 2. ft. 3. ft.
 WELL'S STATIC WATER LEVEL... 74' ft. below land surface measured on mo/day/yr... 7/10/97
 Pump test data: Well water was ft. after hours pumping gpm
 Est. Yield... 60 gpm: Well water was ft. after hours pumping gpm
 Bore Hole Diameter... 12" in. to ft., and in. to ft.
 WELL WATER TO BE USED AS:
 5 Public water supply 8 Air conditioning 11 Injection well
 1 Domestic 3 Feedlot 6 Oil field water supply 9 Dewatering 12 Other (Specify below)
 2 Irrigation 4 Industrial 7 Lawn and garden only 10 Monitoring well
 Was a chemical/bacteriological sample submitted to Department? Yes.....No...X..... If yes, mo/day/yr sample was submitted
 Water Well Disinfected? Yes X No

5 TYPE OF BLANK CASING USED:
 1 Steel 3 RMP (SR) 6 Asbestos-Cement 9 Other (specify below) Welded
 2 PVC 4 ABS 7 Fiberglass Threaded.....
 Blank casing diameter... 5" in. to 0-144 ft., Dia... 5" in. to 154-156 ft., Dia... in. to ft.
 Casing height above land surface... 24" in., weight... 2.82 lbs./ft. Wall thickness or gauge No. ... 258
 TYPE OF SCREEN OR PERFORATION MATERIAL:
 1 Steel 3 Stainless steel 5 Fiberglass 8 RMP (SR) 11 Other (specify)
 2 Brass 4 Galvanized steel 6 Concrete tile 9 ABS 12 None used (open hole)
 SCREEN OR PERFORATION OPENINGS ARE:
 1 Continuous slot 3 Mill slot 5 Gauzed wrapped 8 Saw cut 11 None (open hole)
 2 Louvered shutter 4 Key punched 6 Wire wrapped 9 Drilled holes
 7 Torch cut 10 Other (specify)
 SCREEN-PERFORATED INTERVALS: From... 144 ft. to... 154 ft., From ft. to ft.
 From ft. to ft., From ft. to ft.
 GRAVEL PACK INTERVALS: From... 24 ft. to... 156 ft., From ft. to ft.
 From ft. to ft., From ft. to ft.

6 GROUT MATERIAL: 1 Neat cement 2 Cement grout 3 Bentonite 4 Other
 Grout Intervals: From... 4 ft. to... 24 ft., From ft. to ft.
 What is the nearest source of possible contamination:
 1 Septic tank 4 Lateral lines 7 Pit privy 10 Livestock pens 14 Abandoned water well
 2 Sewer lines 5 Cess pool 8 Sewage lagoon 11 Fuel storage 15 Oil well/Gas well
 3 Watertight sewer lines 6 Seepage pit 9 Feedyard 12 Fertilizer storage 16 Other (specify below)
 13 Insecticide storage
 Direction from well? North How many feet? 80'

FROM	TO	LITHOLOGIC LOG	FROM	TO	PLUGGING INTERVALS
0	11	Fine Sand-Silty-Brown			
11	27	Clay-Brown-Silty			
27-31		Fine Sand-Brown			
31	34	Clay-Brown-Silty			
34	38	Fine Sand-Brown-Silty			
38	46	Clay-Brown-Silty			
46	64	Fine Sand-Brown			
64	89	Clay-Brown-silty			
89	99	Fine Sand-Brown			
99	100	Clay-Brown			
101	151	Fine Sand-Brown			
151	154	Fine Sand-Coarse Sand-Med Gravel-Br			
154	158	FS-CS-Med-Pea Chert Gravel 1/4x3/8			
158		Limestone-Grey			

7 CONTRACTOR'S OR LANDOWNER'S CERTIFICATION: This water well was (1) constructed, (2) reconstructed, or (3) plugged under my jurisdiction and was completed on (mo/day/year) 7/10/97 and this record is true to the best of my knowledge and belief. Kansas Water Well Contractor's License No. 182 This Water Well Record was completed on (mo/day/yr) 8-4-97 under the business name of STRADER DRILLING CO., INC. by (signature) Dale Skron