

USE TYPEWRITER OR BALL POINT PEN-PRESS FIRMLY, PRINT CLEARLY.

WATER WELL RECORD
KSA 82a-1201-1215


T R EW sec 1/4 1/4 1/4 No.

Kansas State Dept. Of Health
(Water Well Contractors)
Forbes-Bldg. 740
Topeka, Kansas 66620

SW 1/4 Sec 4

1 Location of well: County Pottawatomie Township name St. George Fraction TRACT 4 Section number 10-4 Town number 185 Range number 9-95

Distance and direction from nearest town or city: 1 1/2 N.E. ST. GEO., KS. 3 Owner of well: RAY Stephenson
Street address of well location if in city: Address: St. George, KANS

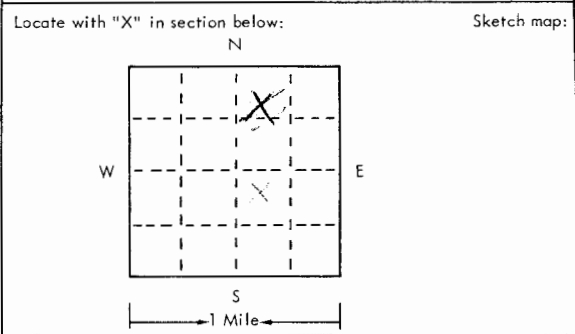

4 Well depth: 160 ft. Date of completion 2-17-75
Well diameter 8" in.

5 Cable tool Rotary Driven Dug
 Hollow rod Jetted Bored Reverse rotary

6 Use: Domestic Public supply Industry
 Irrigation Air conditioning Commercial
 Test well

7 Casing: Material PVC Height: above/below
Threaded Welded Surface 24 in.
Diam. Weight 233 lbs./ft.
5 in. to 160 ft. depth! Drive shoe? Yes No
 in. to ft. depth!

2	Type and color of material	From	To
	Top Soil	0	3
	Brown Clay	3	40
	Blue Shale	40	61
	Grey limestone	61	65
	Grey Shale	65	90
	Grey limestone	90	95
	Grey Shale	95	100
	Grey sandstone	100	110
	Blue Shale	110	120
	Grey limestone	120	125
	Blue Shale	125	160
	(use a second sheet if needed)		

8 Screen: Manufacturer Pumped
Type PVC Dia. 5"
Slot/groove 1.080 Length 20'
Set between 100 ft. and 140 ft.
Fittings: Gravel pack Yes No Size range of material 4x8

9 Static water level: NOT MEASURED
 ft. below land surface Date

10 Pumping level below land surfaces: AIR TEST
 ft. after hrs. pumping g.p.m.
 ft. after hrs. pumping g.p.m.
Estimated maximum yield 3 g.p.m.

11 Water sample submitted:
 Yes No Date

12 Well head completion:
 Pitless adapter Inches above grade

13 Well grouted? Yes No
 Neat cement Bentonite
Depth: From 0 ft. to 10 ft.

14 Nearest source of possible contamination:
ft. 150 Direction EAST Type SEPTIC TANK
Well disinfected upon completion? Yes No

15 Pump: Not installed
Manufacturer's name
Model number HP Volts
Length of drop pipe ft. capacity g.m.p.
Type:
 Submersible Turbine
 Jet Reciprocating
 Centrifugal Other

16 Remarks: elevation 45

Topography:
 Hill
 Slope
 Upland
 Valley

17 Water well contractor's certification:
This well was drilled under my jurisdiction and this report is true to the best of my knowledge and belief.
Strader Drilling Co. Inc. #182
Business name License No.
Address 1125 N. Hutton, Kansas
Signed Del. Adams Date 2-24-75
Authorized representative