


1 LOCATION OF WATER WELL: Fraction NW 1/4 SE 1/4 NW 1/4 Section Number 7 Township Number T 10 S Range Number R 9 E/W  
 County: POTTAWATOMIE

Distance and direction from nearest town or city street address of well if located within city?  
2 miles west, 1/2 north of St. George

2 WATER WELL OWNER: Stanley Clark  
 RR#, St. Address, Box # : 11085 Vesper Board of Agriculture, Division of Water Resources  
 City, State, ZIP Code : St. George, KS 66535 Application Number:

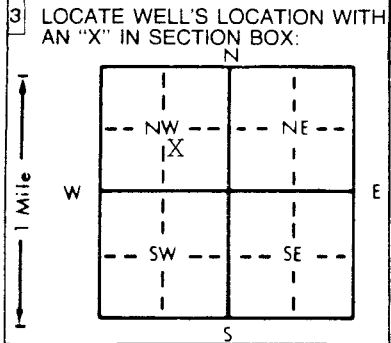

4 DEPTH OF COMPLETED WELL... 98' ft. ELEVATION:  
 Depth(s) Groundwater Encountered 1. .... ft. 2. .... ft. 3. .... ft.  
 WELL'S STATIC WATER LEVEL ... 64' ft. below land surface measured on mo/day/yr 2/26/98  
 Pump test data: Well water was .... ft. after .... hours pumping .... gpm  
 Est. Yield 15 gpm: Well water was .... ft. after .... hours pumping .... gpm  
 Bore Hole Diameter... 12" in. to .... ft., and .... in. to .... ft.  
 WELL WATER TO BE USED AS:  
 5 Public water supply 8 Air conditioning 11 Injection well  
 1 Domestic 3 Feedlot 6 Oil field water supply 9 Dewatering 12 Other (Specify below)  
 2 Irrigation 4 Industrial 7 Lawn and garden only 10 Monitoring well  
 Was a chemical/bacteriological sample submitted to Department? Yes.....No...X.....; If yes, mo/day/yr sample was submitted  
 Water Well Disinfected? Yes X No

5 TYPE OF BLANK CASING USED:  
 1 Steel 3 RMP (SR) 5 Wrought iron 8 Concrete tile CASING JOINTS: Glued X Clamped  
 2 PVC 4 ABS 6 Asbestos-Cement 9 Other (specify below) Welded  
 7 Fiberglass Threaded  
 Blank casing diameter ..... 5" in. to 0-78 ft., Dia 5" in. to 88-96 ft., Dia ..... in. to ..... ft.  
 Casing height above land surface..... 24" in., weight 2.82 lbs./ft. Wall thickness or gauge No. ....258  
 TYPE OF SCREEN OR PERFORATION MATERIAL:  
 1 Steel 3 Stainless steel 5 Fiberglass 7 PVC 10 Asbestos-cement  
 2 Brass 4 Galvanized steel 6 Concrete tile 8 RMP (SR) 11 Other (specify)  
 9 ABS 12 None used (open hole)  
 SCREEN OR PERFORATION OPENINGS ARE:  
 1 Continuous slot 3 Mill slot 5 Gauzed wrapped 8 Saw cut 11 None (open hole)  
 2 Louvered shutter 4 Key punched 6 Wire wrapped 9 Drilled holes  
 7 Torch cut 10 Other (specify)  
 SCREEN-PERFORATED INTERVALS: From ..... 78 ft. to ..... 88 ft., From ..... ft. to ..... ft.  
 From ..... 96 ft. to ..... 98 ft., From ..... ft. to ..... ft.  
 GRAVEL PACK INTERVALS: From ..... 24 ft. to ..... 98 ft., From ..... ft. to ..... ft.  
 From ..... ft. to ..... ft., From ..... ft. to ..... ft.

6 GROUT MATERIAL: 1 Neat cement 2 Cement grout 3 Bentonite 4 Other  
 Grout Intervals: From ..... 4 ft. to ..... 24 ft., From ..... ft. to ..... ft., From ..... ft. to ..... ft.  
 What is the nearest source of possible contamination:  
 1 Septic tank 4 Lateral lines 7 Pit privy 10 Livestock pens 14 Abandoned water well  
 2 Sewer lines 5 Cess pool 8 Sewage lagoon 11 Fuel storage 15 Oil well/Gas well  
 3 Watertight sewer lines 6 Seepage pit 9 Feedyard 12 Fertilizer storage 16 Other (specify below)  
 13 Insecticide storage  
 Direction from well? north How many feet? 140'

FROM	TO	LITHOLOGIC LOG	FROM	TO	PLUGGING INTERVALS
0	1	Top Soil			
1	20	Clay-Brown-Silty			
20	35	Fine Silt-Brown			
35	76	Clay-Brown-Silty			
76	80	Fine Sand-Coarse Sand-Brown			
80	86	Fine Sand-Coarse Sand-Med-Pea Gravel, Brown			
86	95	Clay-Brown			
95	97	Boulders			
97	100	Shale-Grey			

7 CONTRACTOR'S OR LANDOWNER'S CERTIFICATION: This water well was (1) constructed, (2) reconstructed, or (3) plugged under my jurisdiction and was completed on (mo/day/year) 2/26/98 and this record is true to the best of my knowledge and belief. Kansas Water Well Contractor's License No. 182 This Water Well Record was completed on (mo/day/yr) 3-4-98 under the business name of STRADER DRILLING CO., INC. by (signature) Dale Strader