USE TYPEWRITER OR BALL POINT PEN-PRESS FIRMLY, PRINT CLEARLY.

WATER WELL RECORD
KSA 82a-1201-1215

Kansas Department of Health and Environment-Division of Environment
(Water well Contractors)
Topeka, Kansas 66620

1. Location of well:	County: Pottawatomie	Fraction: SE 1/4 SE 1/4 SE 1/4	Section number: 2	Township number: T 10 South	Range number: R 9 E/W

2. Distance and direction from nearest town or city: Wamego West on Hiway no 24 3 miles + 300 ft north on West side of Clark road
Street address of well location if in city:

3. Owner of well: Warren J. Hildreth
R.R. or street: 804, 4th
City, state, zip code: Wamego Kans

4. Locate with "X" in section below:

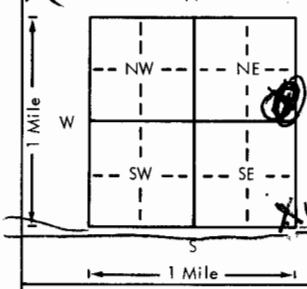

well is here
24 Hway west wamego

6. Bore hole dia. 7 in. Completion date Oct. 9 - 79
Well depth 92 ft.

7. X Cable tool __ Rotary __ Driven __ Dug
__ Hollow rod __ Jetted __ Bored __ Reverse rotary

8. Use: X Domestic __ Public supply __ Industry
__ Irrigation __ Air conditioning __ Stock
__ Lawn __ Oil field water __ Other

9. Casing: Material Steel Height: Above (circled) or below
Threaded ___ Welded ___ Surface 24 in.
RMP ___ PVC ___ Weight ___ lbs./ft.
Dia. 7 in. to 77 ft. depth Wall Thickness or Gauge 23 Wall
Dia. 3 in. to 92 ft. depth Wall Can't read

10. Screen: Manufacturer's name
Type Styrene Plastic Dia. 5"
Slot/gauze .025 Length 20'
Set between 72 ft. and 92 ft.
ft. and ft.
Gravel pack? X Size range of material 16 X 8

11. Static water level: mo./day/yr.
50 ft. below land surface Date 10-9-79

12. Pumping level below land surfaces:
ft. after hrs. pumping g.p.m.
ft. after hrs. pumping g.p.m.
Estimated maximum yield 12 g.p.m.

13. Water sample submitted: mo./day/yr.
__ Yes X No Date

14. Well head completion: NA
__ Pitless adapter Inches above grade

15. Well grouted? X 1-2
With: __ Neat cement __ Bentonite X Concrete
Depth: From 16 ft. to 5 ft.

16. Nearest source of possible contamination:
ft. 125 Direction West Type Septic Tank
Well disinfected upon completion? X Yes __ No

17. Pump: X Not installed
Manufacturer's name
Model number HP Volts
Length of drop pipe ft. capacity g.p.m.
Type:
__ Submersible __ Turbine
__ Jet __ Reciprocating
__ Centrifugal __ Other

5. Type and color of material

	From	To
top Soil Sandy	0	10
Loam, Sandy	10	47
Gravel, fine	47	50
Quick Sand yellow	50	70
Sand, yellow Water Sand	70	76
Shale, Blue	76	92

(Use a second sheet if needed)

T 10 S R 9 E/W Sec 2 1/4 1/4 1/4 1/4 SE SE SE 79

18. Elevation:

Topography:
__ Hill
__ Slope
X Upland
__ Valley

19. Remarks:

20. Water well contractor's certification:
This well was drilled under my jurisdiction and this report is true to the best of my knowledge and belief.
Business name Strader Drilling Co License No. 237
Address Blue Rapids KS
Signed Harold Strader Date 10-9
Authorized representative

Forward the white, blue and pink copies to the Department of Health and Environment

Form WWC-5

MI-1023