


LOCATION OF WATER WELL: Fraction NE 1/4 NE 1/4 SE 1/4 Section Number 4 Township Number T 10 S Range Number R 9 EXX
 County: Pottawatomie
 Distance and direction from nearest town or city street address of well if located within city?

5 1/2 mi. west of Wamego, Kansas

WATER WELL OWNER: State of Kansas c/o Kansas Dept. of Transportation
 RR#, St. Address, Box #: Docking State Office Bldg. Board of Agriculture, Division of Water Resources
 City, State, ZIP Code: Topeka, Kansas 66612 Application Number: NA

LOCATE WELL'S LOCATION WITH AN "X" IN SECTION BOX:

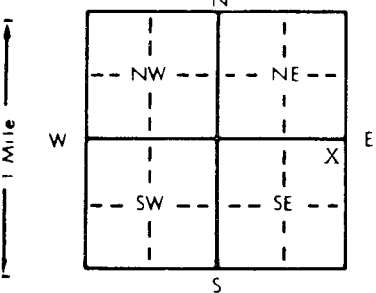

DEPTH OF COMPLETED WELL over 100 ft. ELEVATION: unk.
 Depth(s) Groundwater Encountered 1. 55 ft. 2. ft. 3. ft.
 WELL'S STATIC WATER LEVEL 55 ft. below land surface measured on mo/day/yr 1/12/94.
 Pump test data: Well water was NA ft. after hours pumping gpm
 Est. Yield gpm: Well water was ft. after hours pumping gpm
 Bore Hole Diameter in. to ft., and in. to ft.
 WELL WATER TO BE USED AS:
 1 5 Public water supply 8 Air conditioning 11 Injection well
 ① Domestic 3 Feedlot 6 Oil field water supply 9 Dewatering 12 Other (Specify below)
 2 Irrigation 4 Industrial 7 Lawn and garden only 10 Monitoring well
 Was a chemical/bacteriological sample submitted to Department? Yes No; If yes, mo/day/yr sample was submitted
 Water Well Disinfected? Yes No

TYPE OF BLANK CASING USED: 2 5 Wrought iron 8 Concrete tile CASING JOINTS: Glued Clamped
 1 Steel 3 RMP (SR) 6 Asbestos-Cement 9 Other (specify below) Welded
 2 PVC 4 ABS 7 Fiberglass Threaded

Blank casing diameter 6 in. to at surf. ft., Dia unk. in. to ft., Dia in. to ft.
 Casing height above land surface 5 ft. below in., weight lbs./ft. Wall thickness or gauge No. 1/4 in.

TYPE OF SCREEN OR PERFORATION MATERIAL:
 1 Steel 3 Stainless steel 5 Fiberglass 7 PVC 10 Asbestos-cement
 2 Brass 4 Galvanized steel 6 Concrete tile 8 RMP (SR) 11 Other (specify) unk.
 12 None used (open hole)

SCREEN OR PERFORATION OPENINGS ARE:
 1 Continuous slot 3 Mill slot 5 Gauzed wrapped 8 Saw cut 11 None (open hole)
 2 Louvered shutter 4 Key punched 6 Wire wrapped 9 Drilled holes
 7 Torch cut 10 Other (specify) unk.

SCREEN-PERFORATED INTERVALS: From NA/unk. ft. to ft., From ft. to ft.
 From ft. to ft., From ft. to ft.
 GRAVEL PACK INTERVALS: From unk. ft. to ft., From ft. to ft.
 From ft. to ft., From ft. to ft.

GROUT MATERIAL: 1 Neat cement 2 Cement grout 3 Bentonite 4 Other unk.
 Grout Intervals: From 53 ft. to 43 ft., From 16 ft. to 6 ft., From ft. to ft.

What is the nearest source of possible contamination: unknown
 1 Septic tank 4 Lateral lines 7 Pit privy 10 Livestock pens 14 Abandoned water well
 2 Sewer lines 5 Cess pool 8 Sewage lagoon 11 Fuel storage 15 Oil well/Gas well
 3 Watertight sewer lines 6 Seepage pit 9 Feedyard 12 Fertilizer storage 16 Other (specify below)
 13 Insecticide storage

Direction from well? How many feet?

FROM	TO	LITHOLOGIC LOG	FROM	TO	PLUGGING INTERVALS
		*	-5	6	Chlorinated sand
			6	16	Bentonite
			16	43	Chl. sand
			43	53	Bentonite
			53	TD	Chl. Sand (Total depth unknown, more than 100 ft.)
					* Wellhead located apprx. 5 ft. below ground. Depths measured from wellhead.

CONTRACTOR'S OR LANDOWNER'S CERTIFICATION: This water well was (1) constructed, (2) reconstructed, or (3) plugged under my jurisdiction and was completed on (mo/day/year) 1/12/94 and this record is true to the best of my knowledge and belief. Kansas Water Well Contractor's License No. NA This Water Well Record was completed on (mo/day/yr) 1/13/94 under the business name of Kansas Dept. of Transportation by (signature) B.L.